



FIRST FLOOR PLAN
(INTERIOR DIMENSIONS)

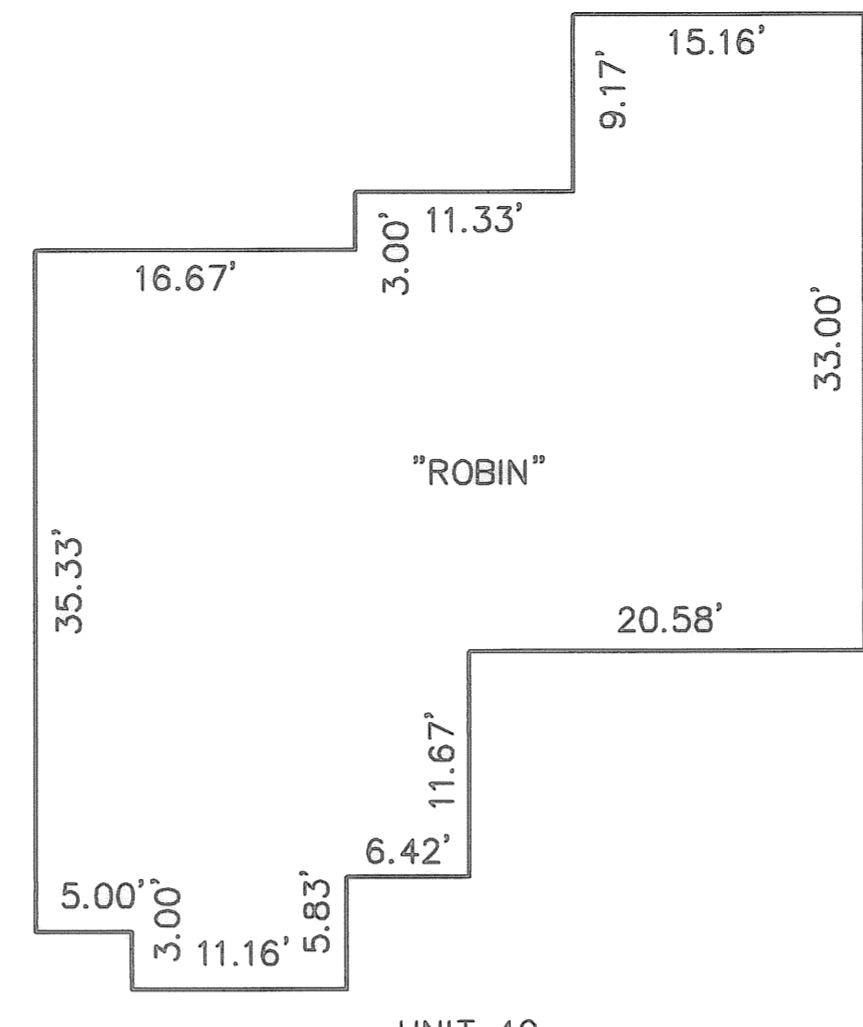


FIRST FLOOR PLAN
(INTERIOR DIMENSIONS)

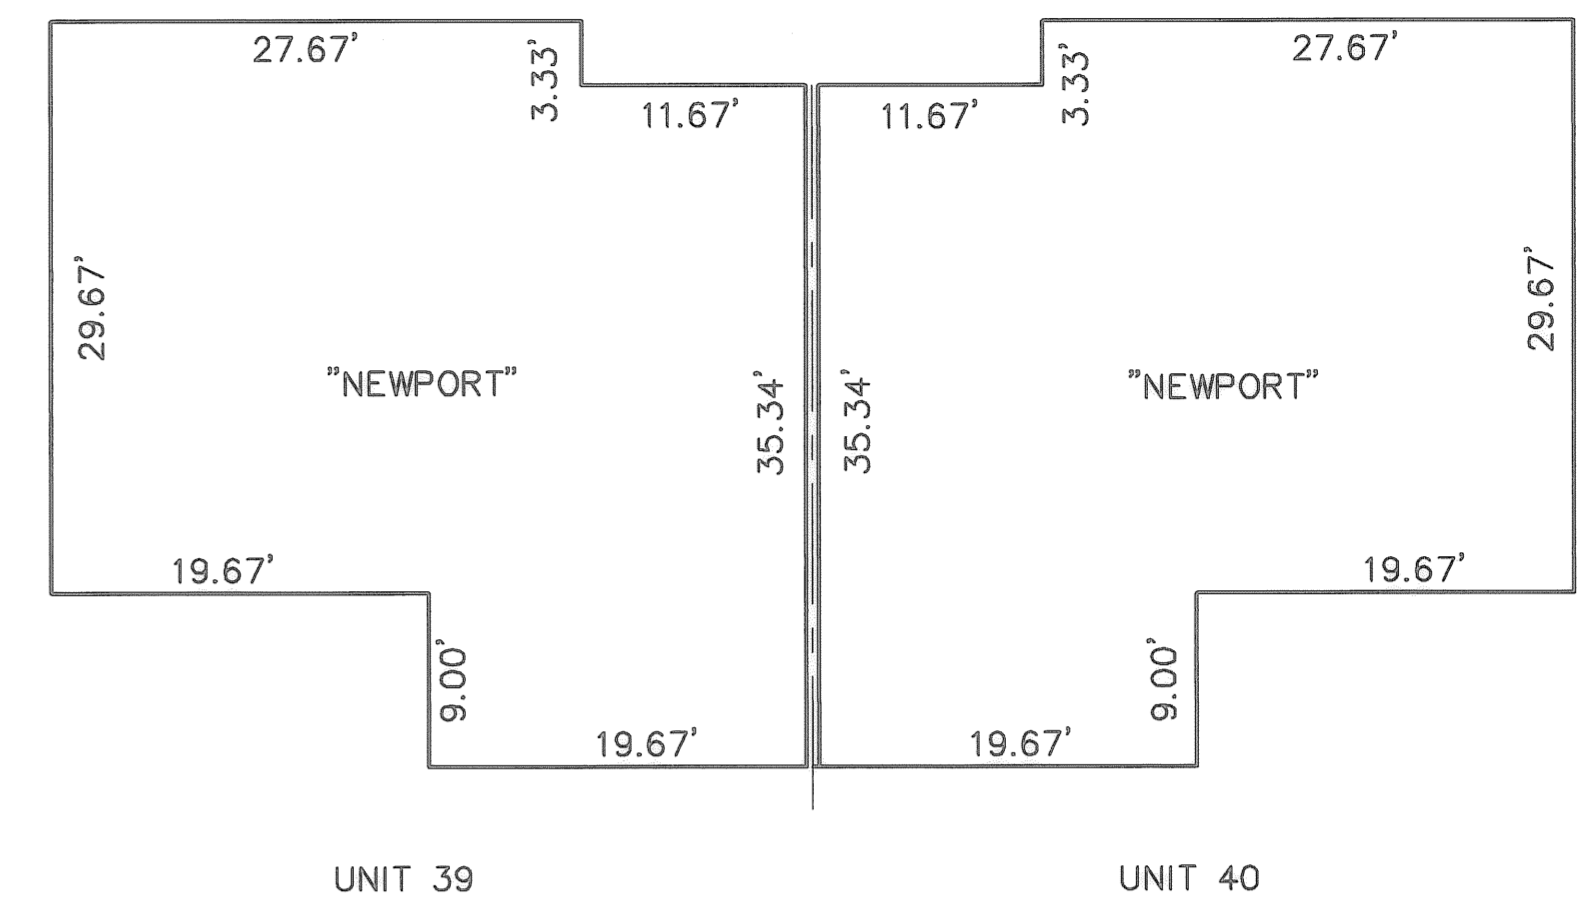


FIRST FLOOR PLAN
(INTERIOR DIMENSIONS)

OWNERSHIP PERCENTAGES


UNIT NO.	SQ. FT.	ELEV. F.F.	% OWNERSHIP
1	1427.16	748.93	2.3654
2	1645.51	749.08	2.7273
3	1427.16	749.45	2.3654
4	1637.92	749.47	2.7147
5	1427.16	749.50	2.3654
6	1427.16	749.44	2.3654
7	1645.51	749.42	2.7273
8	1427.16	749.44	2.3654
9	1645.51	749.84	2.7273
10	1637.92	749.45	2.7147
11	1645.51	748.48	2.7273
12	1427.16	749.86	2.3654
13	1645.51	749.53	2.7273
14	1645.51	749.39	2.7273
15	1645.51	749.69	2.7273
16	1427.16	749.36	2.3654
17	1645.51	749.23	2.7273
18	1154.56	749.35	1.9136
19	1305.39	749.35	2.1636
20	1154.56	749.41	1.9136
21	1154.56	749.41	1.9136
22	1305.39	750.46	2.1636
23	1154.56	750.46	1.9136
24	1645.51	749.53	2.7273
25	1207.46	749.20	2.0012
26	1305.39	749.81	2.1636
27	1154.56	749.81	1.9136
28	1305.39	750.04	2.1636
29	1305.39	750.04	2.1636
30	1427.16	749.50	2.3654
31	1645.51	749.70	2.7273
32	1645.51	749.35	2.7273
33	1645.51	749.07	2.7273
34	1305.39	749.17	2.1636
35	1305.39	749.17	2.1636
36	1207.46	749.26	2.0012
37	1427.16	749.44	2.3654
38	1427.16	749.36	2.3654
39	1305.39	749.84	2.1636
40	1305.39	749.84	2.1636
41	1645.51	749.45	2.7273
42	1460.23	749.69	2.4202
TOTAL	60335.53 S.F.		100.00%

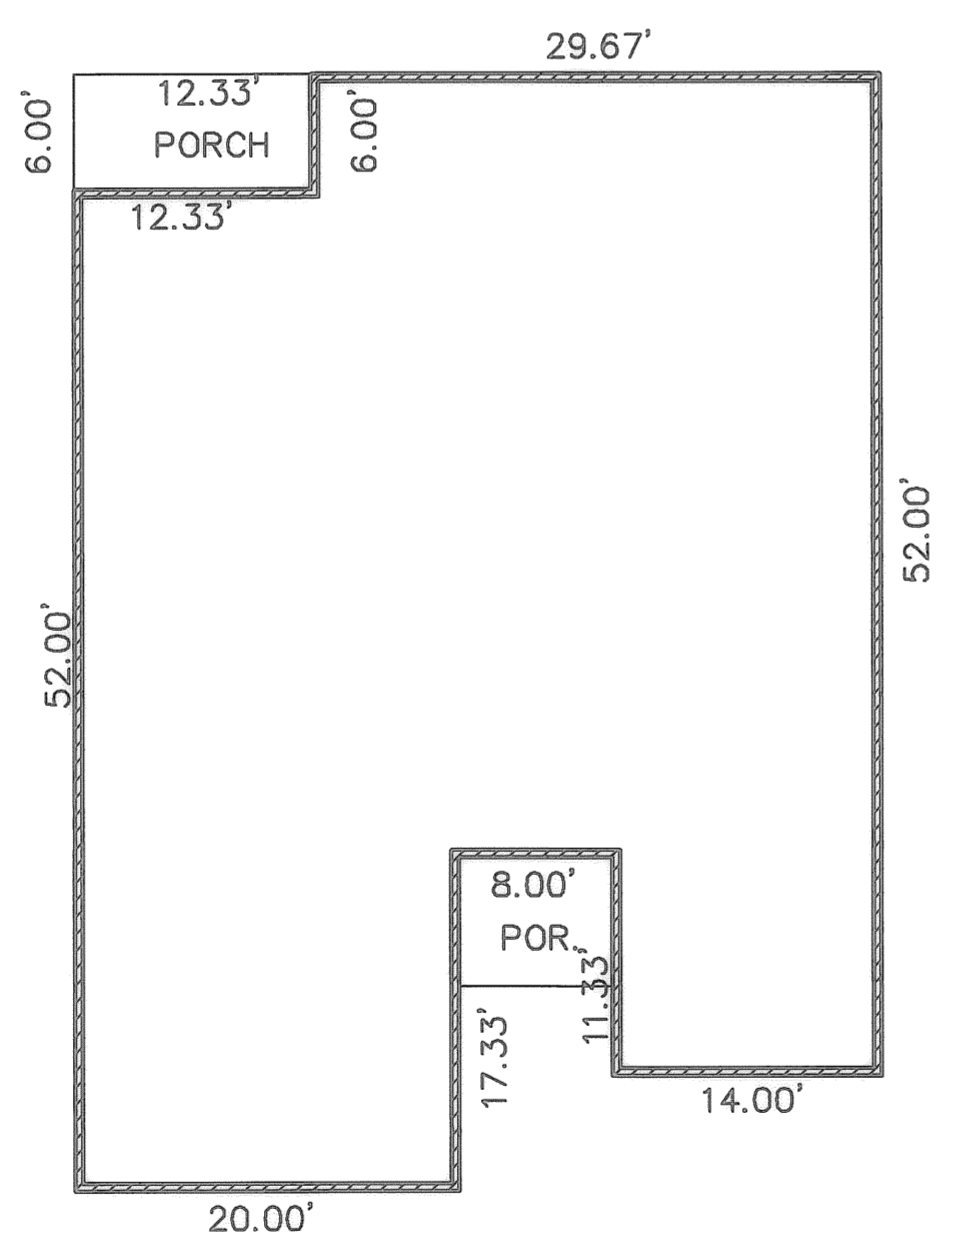

FOUNDATION PLAN
(EXTERIOR DIMENSIONS)

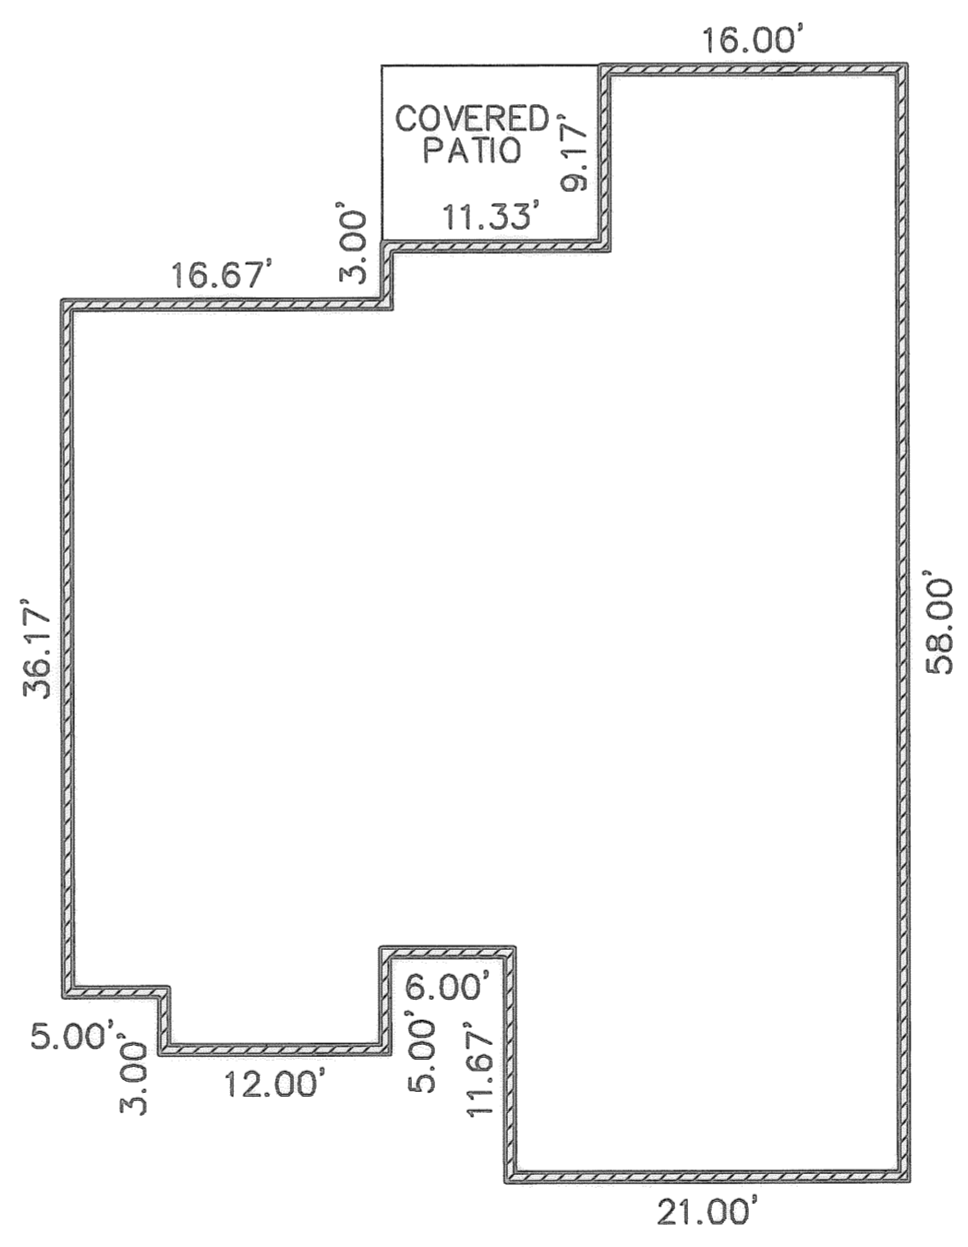



FOUNDATION PLAN
(EXTERIOR DIMENSIONS)

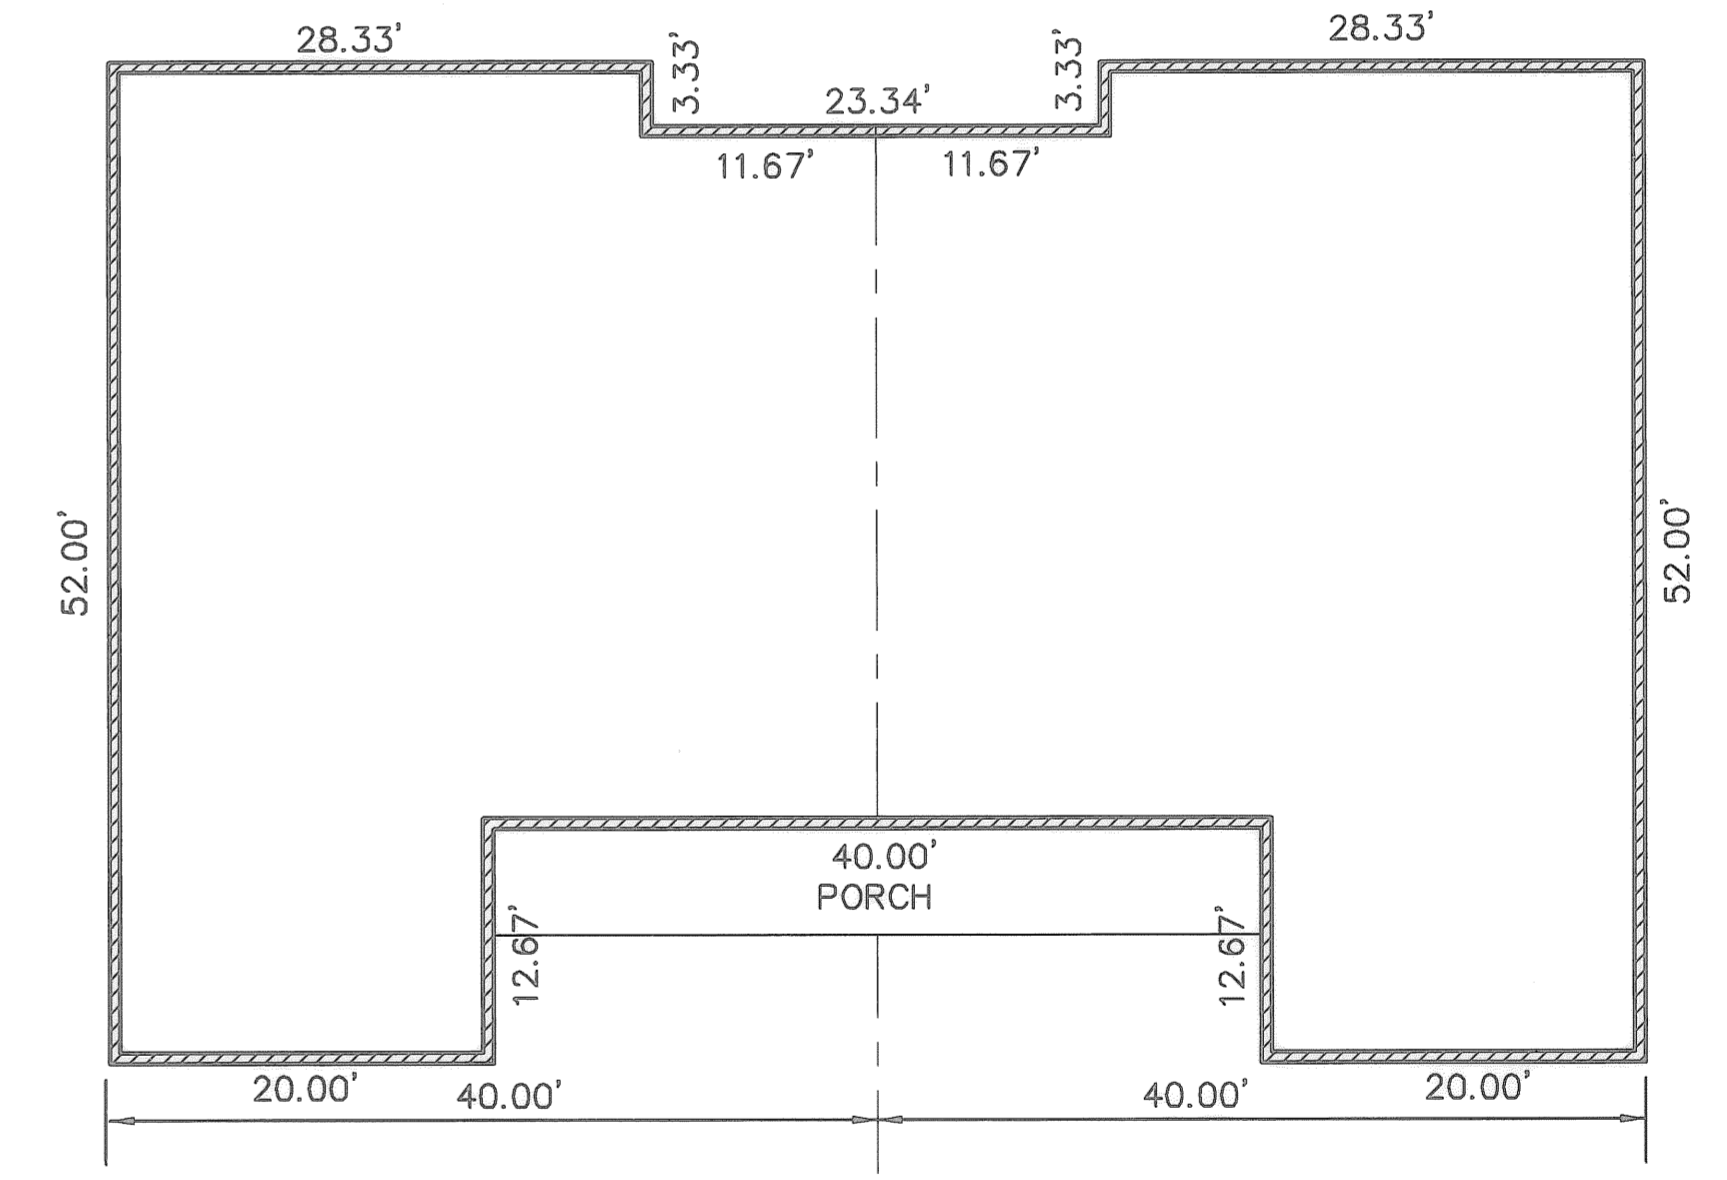

FOUNDATION PLAN
(EXTERIOR DIMENSIONS)

Jeffrey R. Keefe 3-19-07
JEFFREY R. KEEFE
PROFESSIONAL ENGINEER NO. 58389

David L. Elwell 3-17-07
DAVID L. ELWELL
PROFESSIONAL SURVEYOR NO. 6333

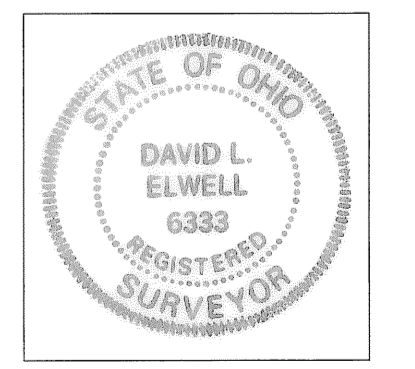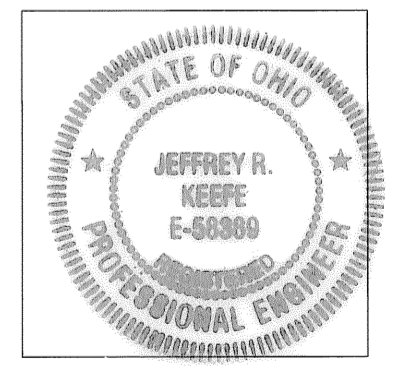

R:\04000\04142-CPB\ldat\control\dwg\8-PLAN01.dwg 3/13/2007 9:27:10 AM EDT

DATE	DESCRIPTION	BY
03-13-07		


KS
KS ASSOCIATES
www.ksassociates.com

KS Associates, Inc.
260 Burns Road, Suite 100
Elyria, OH 44035
P 440 365 4730
F 440 365 4790

**CHESAPEAKE CONDOMINIUM
PHASE NO. 8**
PART OF
ORIGINAL CARLISLE TOWNSHIP SECTION NO. 5
CITY OF ELYRIA COUNTY OF LORAIN STATE OF OHIO

SHEET
2
OF
3
JOB NO.
04142-CPB


R:\04000\04142-CP8\ddt\control\dwg\8-ELEV01.dwg 3/13/2007 9:27:15 AM EDT

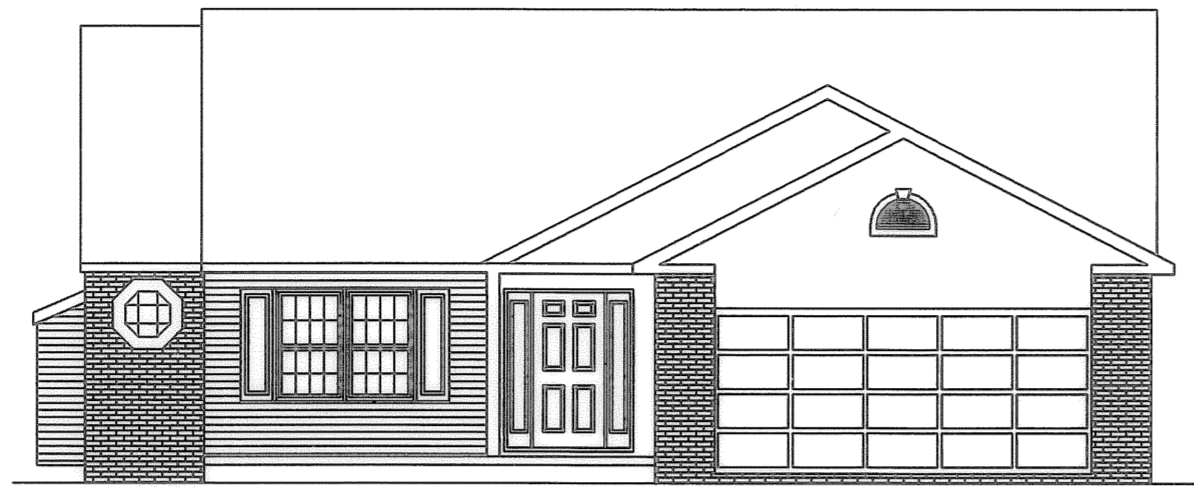


FRONT ELEVATION
ROBIN MODEL




FRONT ELEVATION
CAMBRIDGE MODEL

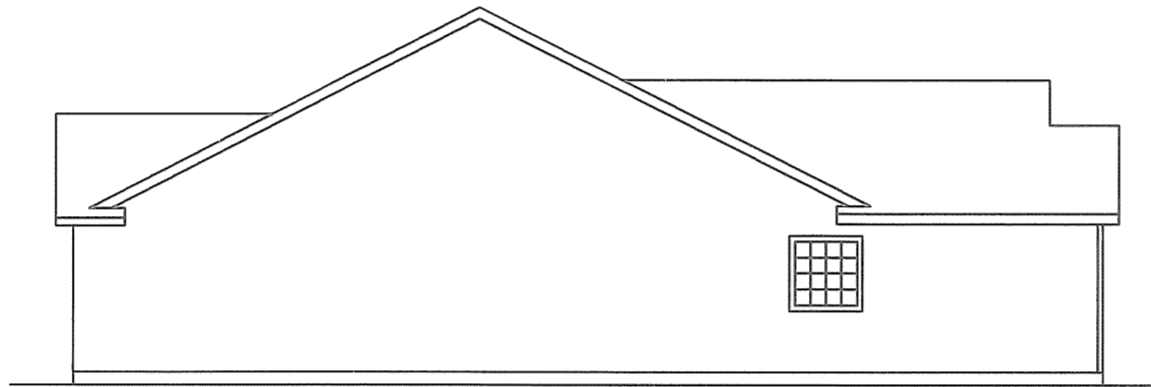


RIGHT SIDE ELEVATION

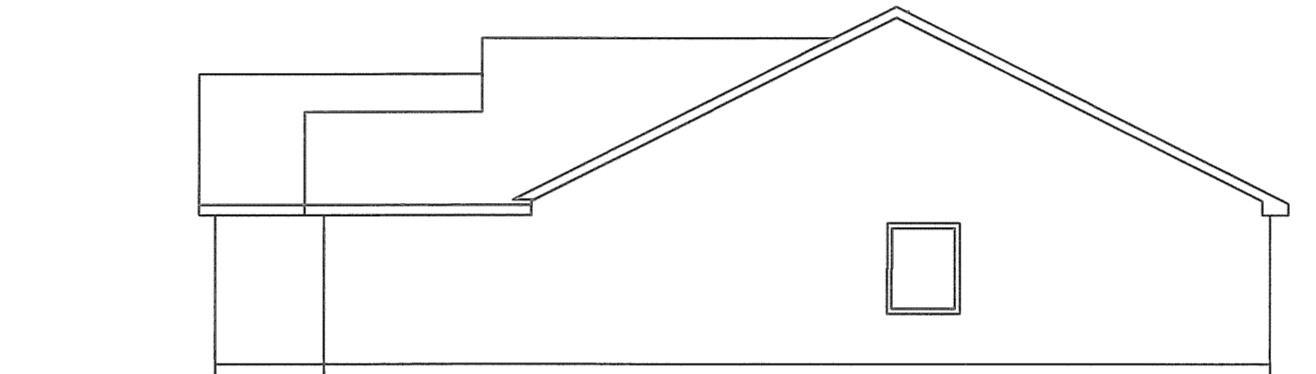


RIGHT SIDE ELEVATION

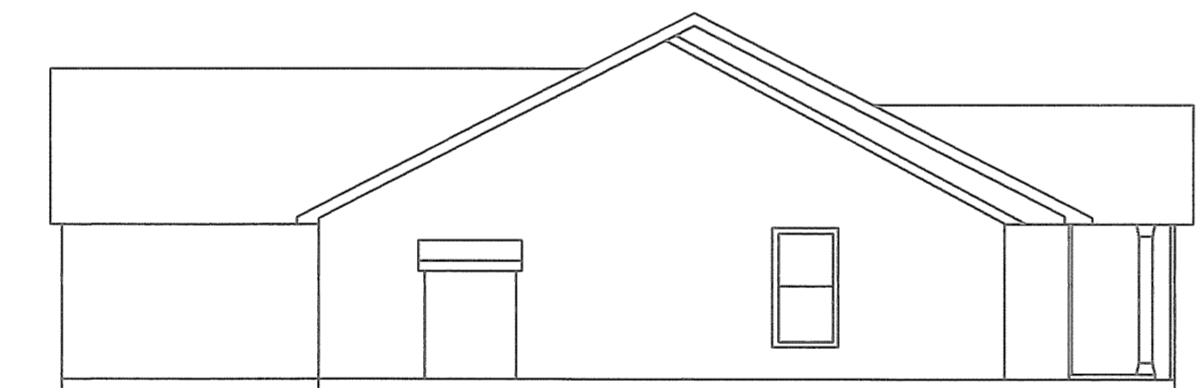


LEFT SIDE ELEVATION

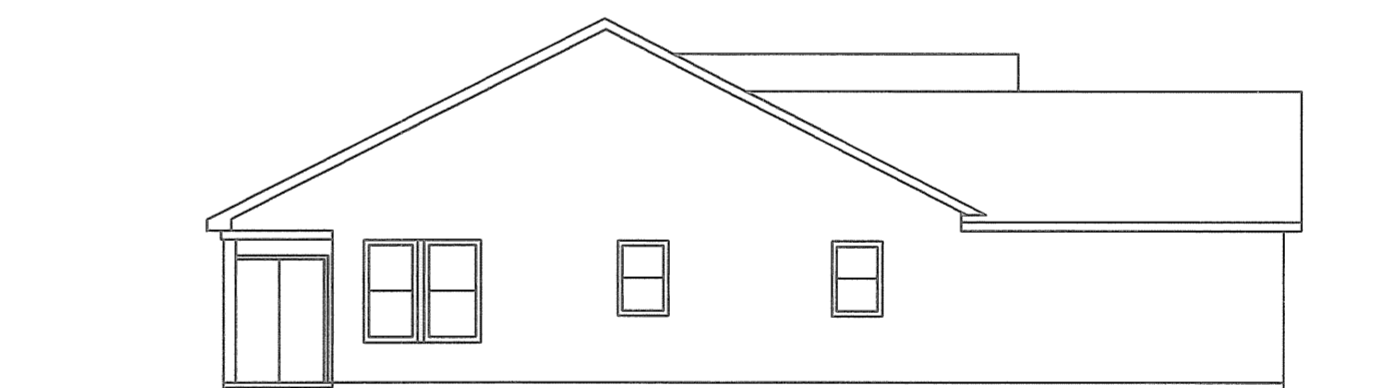

LEFT SIDE ELEVATION

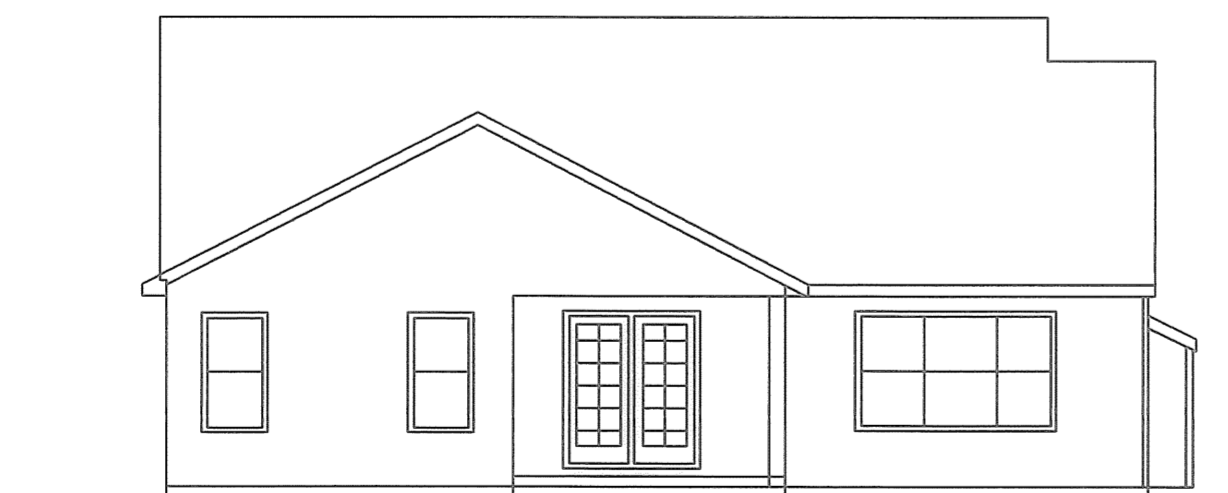

REAR ELEVATION


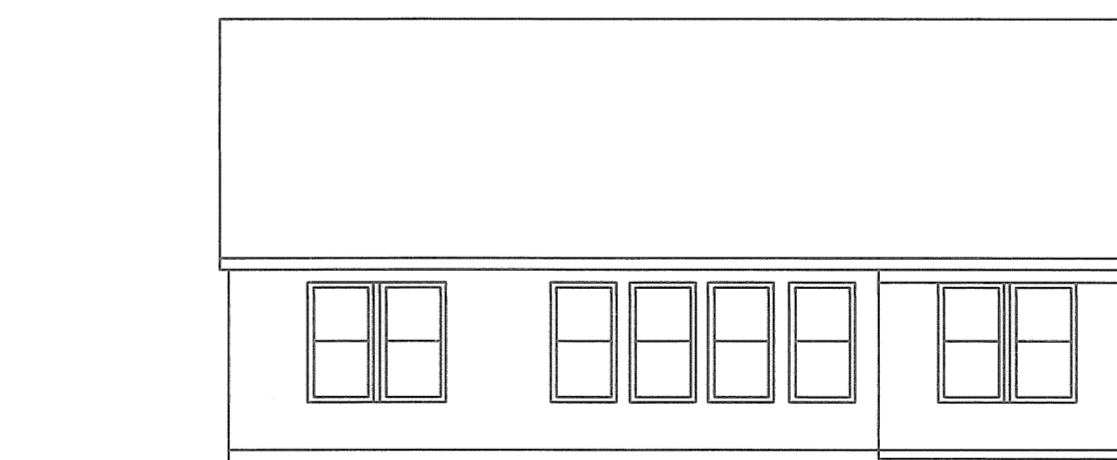


REAR ELEVATION

NOTE: NEWPORT
ELEVATION NOT SHOWN.

Jeffrey R. Keefe 3-19-07
JEFFREY R. KEEFE
PROFESSIONAL ENGINEER NO. 58389

David L. Elwell 3-19-07
DAVID L. ELWELL
PROFESSIONAL SURVEYOR NO. 6333

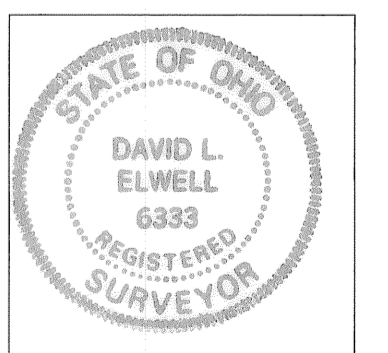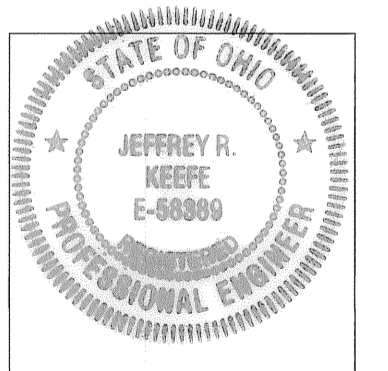

DATE	DESCRIPTION	BY
03-13-07		

KS
KS ASSOCIATES
KS Associates, Inc.
260 Burns Road, Suite 100
Elyria, OH 44035
P 440 365 4730
F 440 365 4790
www.ksassociates.com

**CHESAPEAKE CONDOMINIUM
PHASE NO. 8**
PART OF
ORIGINAL CARLISLE TOWNSHIP SECTION NO. 5
CITY OF ELYRIA COUNTY OF LORAIN STATE OF OHIO

SHEET
3
OF
3
JOB NO.
04142-CP8