




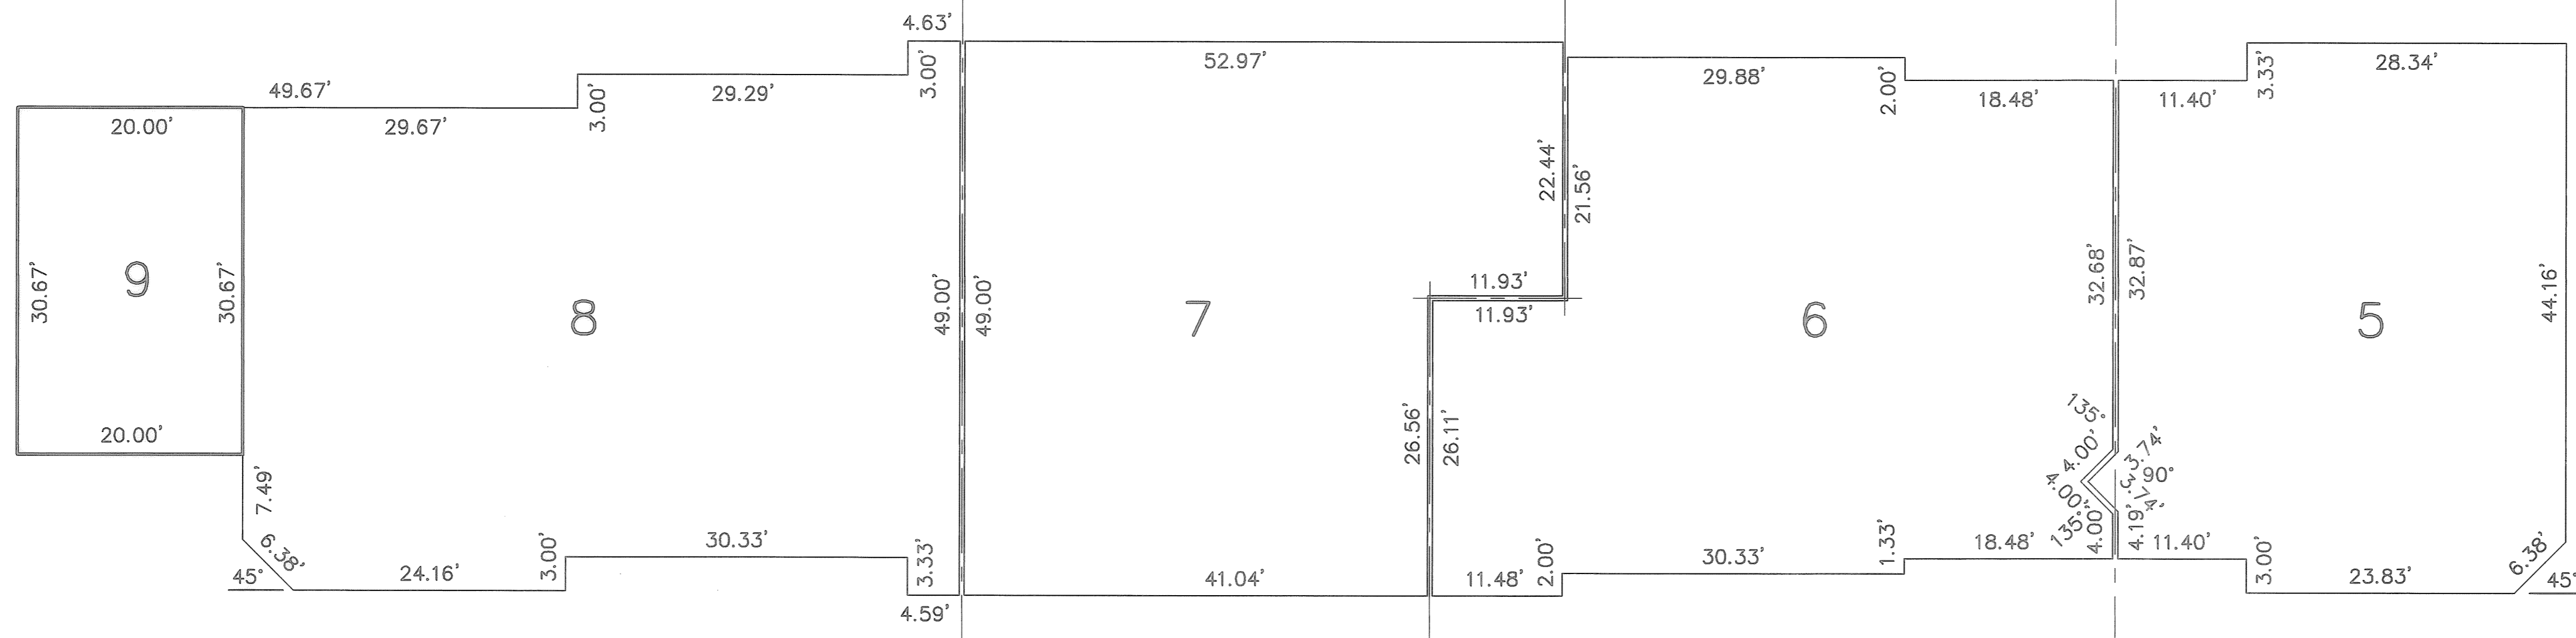

R:\01000\01355-cp3\control\dwg\1--PLAT02.dwg 3/16/2007 8:15:36 AM EST

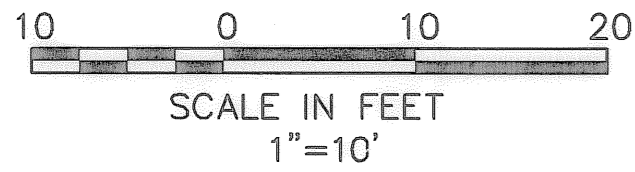

**FIRST FLOOR PLAN**  
(INTERIOR DIMENSIONS)

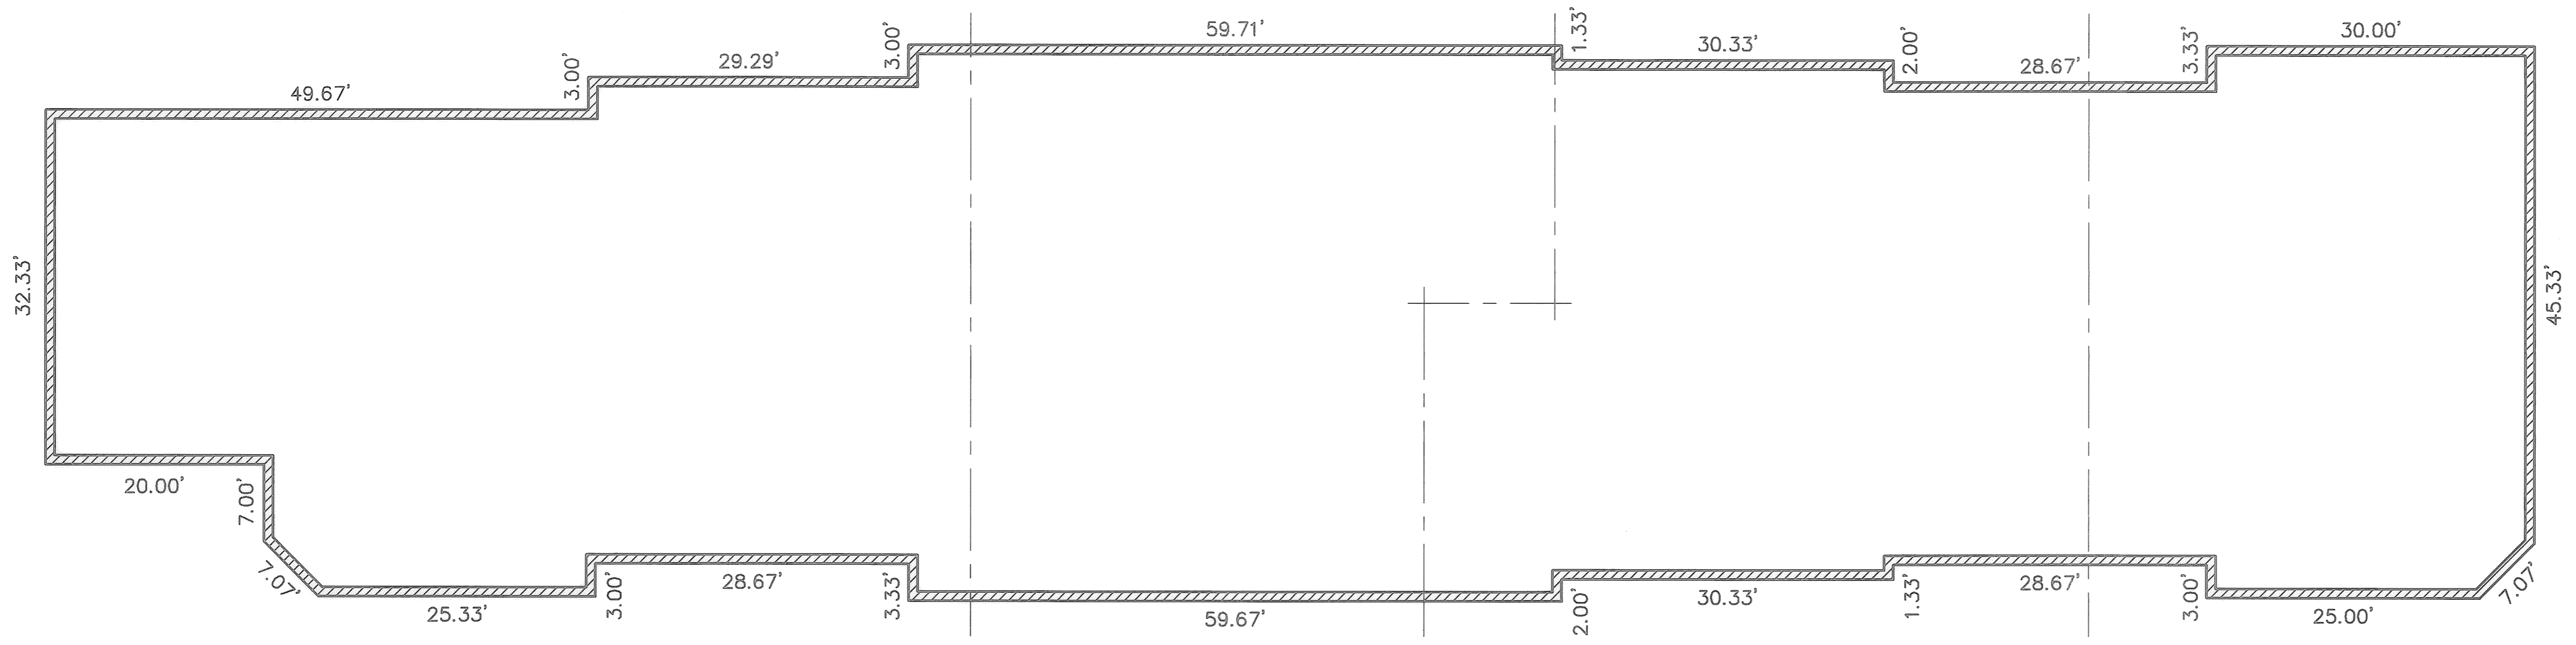


**FOUNDATION PLAN**  
(EXTERIOR DIMENSIONS)

**CERTIFICATION**

THIS IS TO CERTIFY THAT THE ATTACHED DRAWINGS CORRECTLY REPRESENT THE BUILDING AS CONSTRUCTED.

*David L. Elwell* 03-14-07  
DAVID L. ELWELL  
PROFESSIONAL SURVEYOR NO. 6333

*Jeffrey R. Keefe* 03-14-07  
JEFFREY R. KEEFE  
PROFESSIONAL ENGINEER NO. 58389

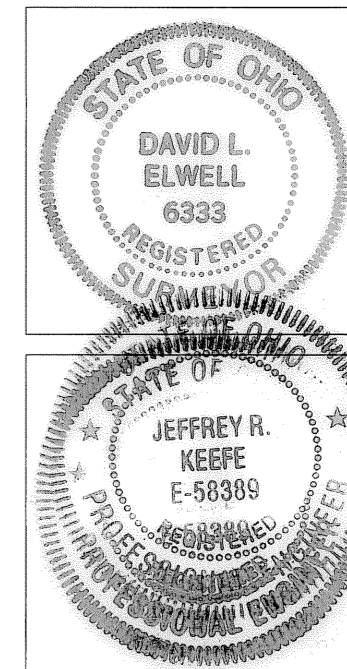

DATE:	03-06-07	DESCRIPTION:	
DRAWN BY:	CPW	DATE:	
CHKD BY:		REVISIONS:	
DWG. NAME:	1-PLAT02		
PATH:	01355-CP3		
F.B.:			


  

KS Associates, Inc. 260 Burns Road, Suite 100 Elyria, OH 44035 P 440 365 4730 F 440 365 4790 www.ksassociates.com	
<b>YORKSHIRE COMMONS</b> <b>CONDOMINIUM PHASE NO. 3</b> A RESUBDIVISION OF PART OF YORKSHIRE COMMONS CONDOMINIUM PHASE NO. 2 P.V. 90 P. 83-85 VILLAGE OF SHEFFIELD COUNTY OF LORAIN STATE OF OHIO	
SHEET	2
OF	3
JOB NO.	01355-CP3


R:\01000\01355-cp3\cadd\control\dwg\1-PLAT03.dwg 3/6/2007 8:15:27 AM EST





FRONT ELEVATION

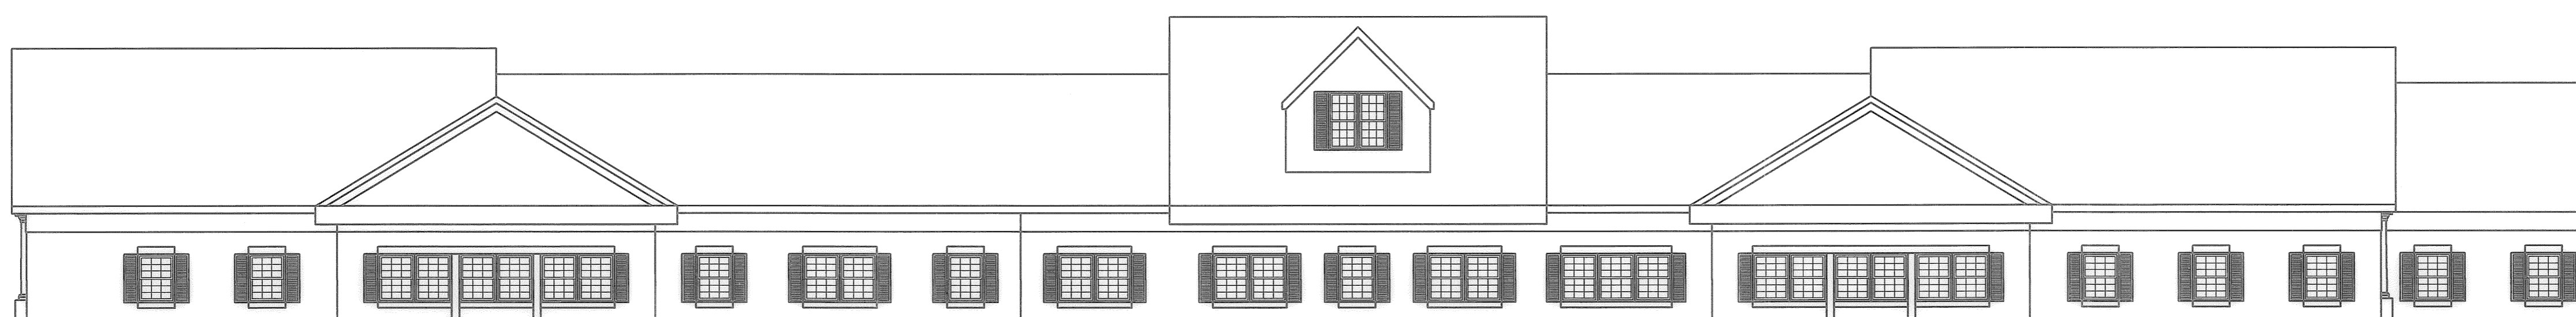

REAR ELEVATION

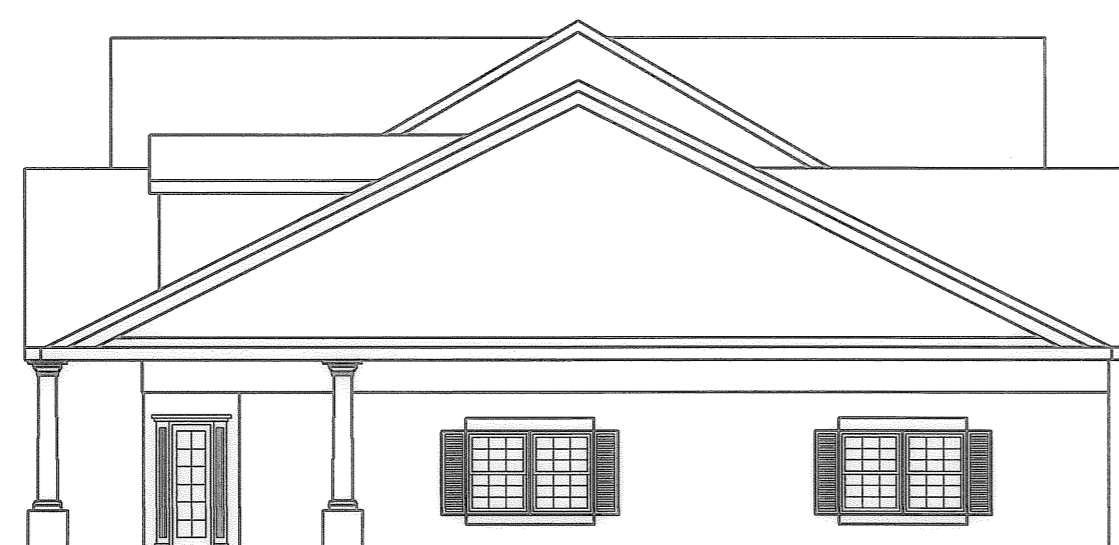

RIGHT SIDE ELEVATION

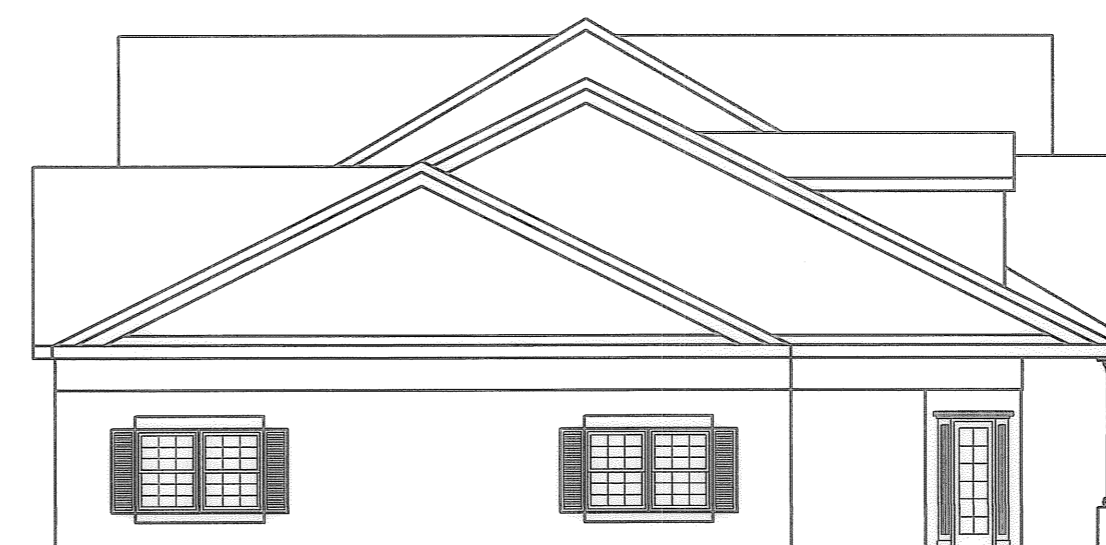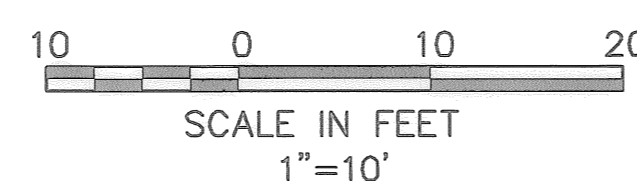

LEFT SIDE ELEVATION


NOTE: BUILDING STYLE SHOWN IS TYPICAL PER PROJECT.

**CERTIFICATION**

THIS IS TO CERTIFY THAT THE ATTACHED DRAWINGS CORRECTLY REPRESENT THE BUILDING AS CONSTRUCTED.

*David L. Elwell* 03-14-07  
 DAVID L. ELWELL  
 PROFESSIONAL SURVEYOR NO. 6333

*Jeffrey R. Keefe* 03-14-07  
 JEFFREY R. KEEFE  
 PROFESSIONAL ENGINEER NO. 58389

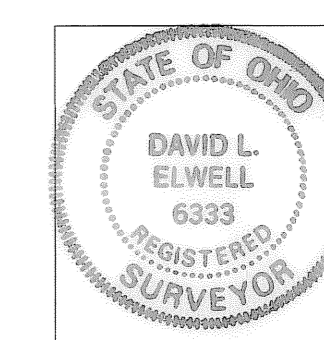

DATE	DESCRIPTION	BY

DATE: 03-06-07	DRAWN BY: CPV
CHECKED BY: 1-PLAT03	DWG. NAME: 01355-CP3
PATH: 01355-CP3	F.B.:

KS Associates, Inc.  
 260 Burns Road, Suite 100  
 Elyria, OH 44035  
 P 440 365 4730  
 F 440 365 4790  
 www.kssassociates.com

**KS ASSOCIATES**

**YORKSHIRE COMMONS CONDOMINIUM PHASE NO. 3**  
 A REBUDIVISION OF PART OF  
 YORKSHIRE COMMONS CONDOMINIUM  
 PHASE NO. 2 P.V. 90 P. 83-85  
 VILLAGE OF SHEFFIELD COUNTY OF LORAIN STATE OF OHIO

SHEET	3
OF	3
JOB NO.	01355-CP3