


REVISIONS	DATE	DESCRIPTION

WATERSIDE CROSSINGS SOUTH CONDOMINIUM NO. 3 PHASE 3
 BEING PART BLOCK "K" OF THE WATERSIDE WEBBER ROAD SUBD. RECORDED IN VOL. 87, PG. 41 & 42, IN SEC. #8, CITY OF AVON LAKE, LORAIN COUNTY, OHIO

CERTIFICATION
 THIS IS TO CERTIFY THAT THE ATTACHED DRAWINGS CORRECTLY REPRESENT THE BUILDINGS AS CONSTRUCTED AND THAT THERE ARE NO ENCROACHMENTS ON ADJUTING PROPERTIES.

[Signature] 9-21-09
 JAMES T. SAYLER, P.E.
 PROFESSIONAL ENGINEER NO. E-52385

[Signature] 9-21-09
 JAMES T. SAYLER
 PROFESSIONAL SURVEYOR NO. S-7425

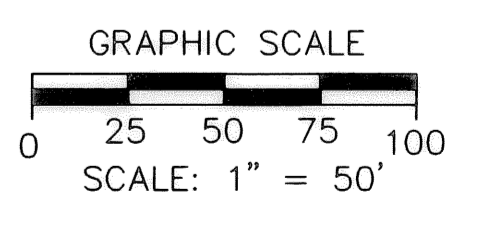

THE HENRY G. REITZ ENGINEERING COMPANY
 4214 ROCKY RIVER DRIVE
 CLEVELAND, OHIO 44135
 PHONE: (216) 251-3033

1/1
 SEPTEMBER 2009

Tax Map Dept Copy #09-01198