


CERTIFICATION

THIS IS TO CERTIFY THAT THE ATTACHED DRAWINGS CORRECTLY REPRESENT THE BUILDINGS AS CONSTRUCTED AND THAT THERE ARE NO ENCROACHMENTS ON ADJUTING PROPERTIES.

[Signature]
JAMES T. SAYLER, P.E.
 PROFESSIONAL ENGINEER NO. E-52385

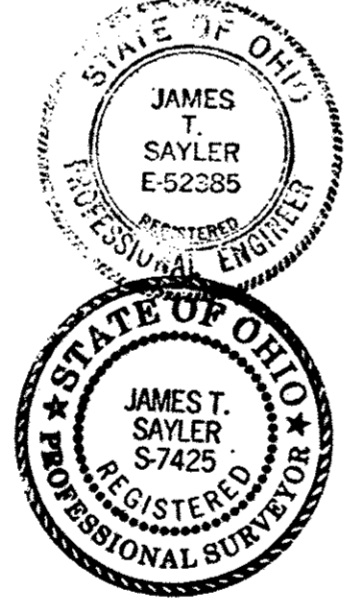

[Signature]
JAMES T. SAYLER
 PROFESSIONAL SURVEYOR NO. S-7425

ACREAGE BREAKDOWN:

PHASE	PARCEL	SQ. FT.	ACRES
PHASE 1	PARCEL A	162,481	3.7301
PHASE 2	PARCEL B	64,008	1.4694
PHASE 3	PARCEL C	25,708	0.5902
PHASE 4	PARCEL D	47,370	1.0875
PHASE 5	PARCEL E & F	58,888	1.3519
REMAINDER, IN 2 PARCELS		137,139	3.1482
TOTAL		495,595	11.3773

Doc ID: 01610720001 Type: OFF
 Kind: PLAT
 Recorded: 10/26/2010 at 10:36:59 AM
 Fee Amt: \$176.80 Page 1 of 1
 Lorain County, Ohio
 Judith M. Hedwick County Recorder
 File # 2010-0351255

LAWYERS TITLE CO
 424 MIDDLE AVE
 ELYRIA, OH 44035
Plot vol. 96
pg. 37, 38

TRANSFERRED
 IN COMPLIANCE WITH SEC. 319-202
 OHIO REV. CODE
 OCT 25 2010
MARK R. STEWART
 LORAIN COUNTY AUDITOR



Reed
mm

REVISIONS	DATE	DESCRIPTION

WATERSIDE CROSSINGS SOUTH CONDOMINIUM NO. 3 PHASE 5
 BEING PART BLOCK "K" OF THE WATERSIDE WEBBER ROAD SUBD. RECORDED IN VOL. 87, PG. 41 & 42, IN SEC. #8, CITY OF AVON LAKE, LORAIN COUNTY, OHIO

THE HENRY G. REITZ ENGINEERING COMPANY
 4214 ROCKY RIVER DRIVE
 CLEVELAND, OHIO 44135
 PHONE: (216) 251-3033


1/2
 SEPTEMBER 2010

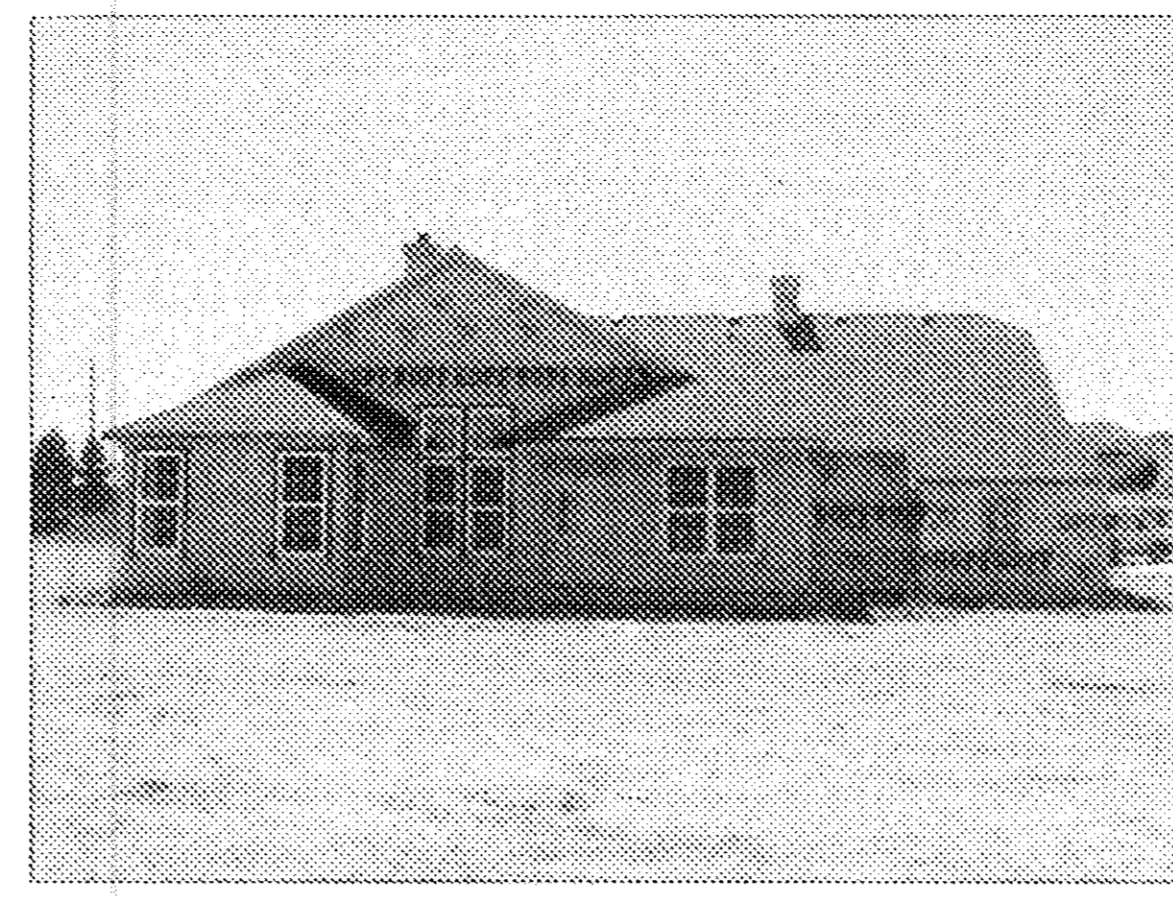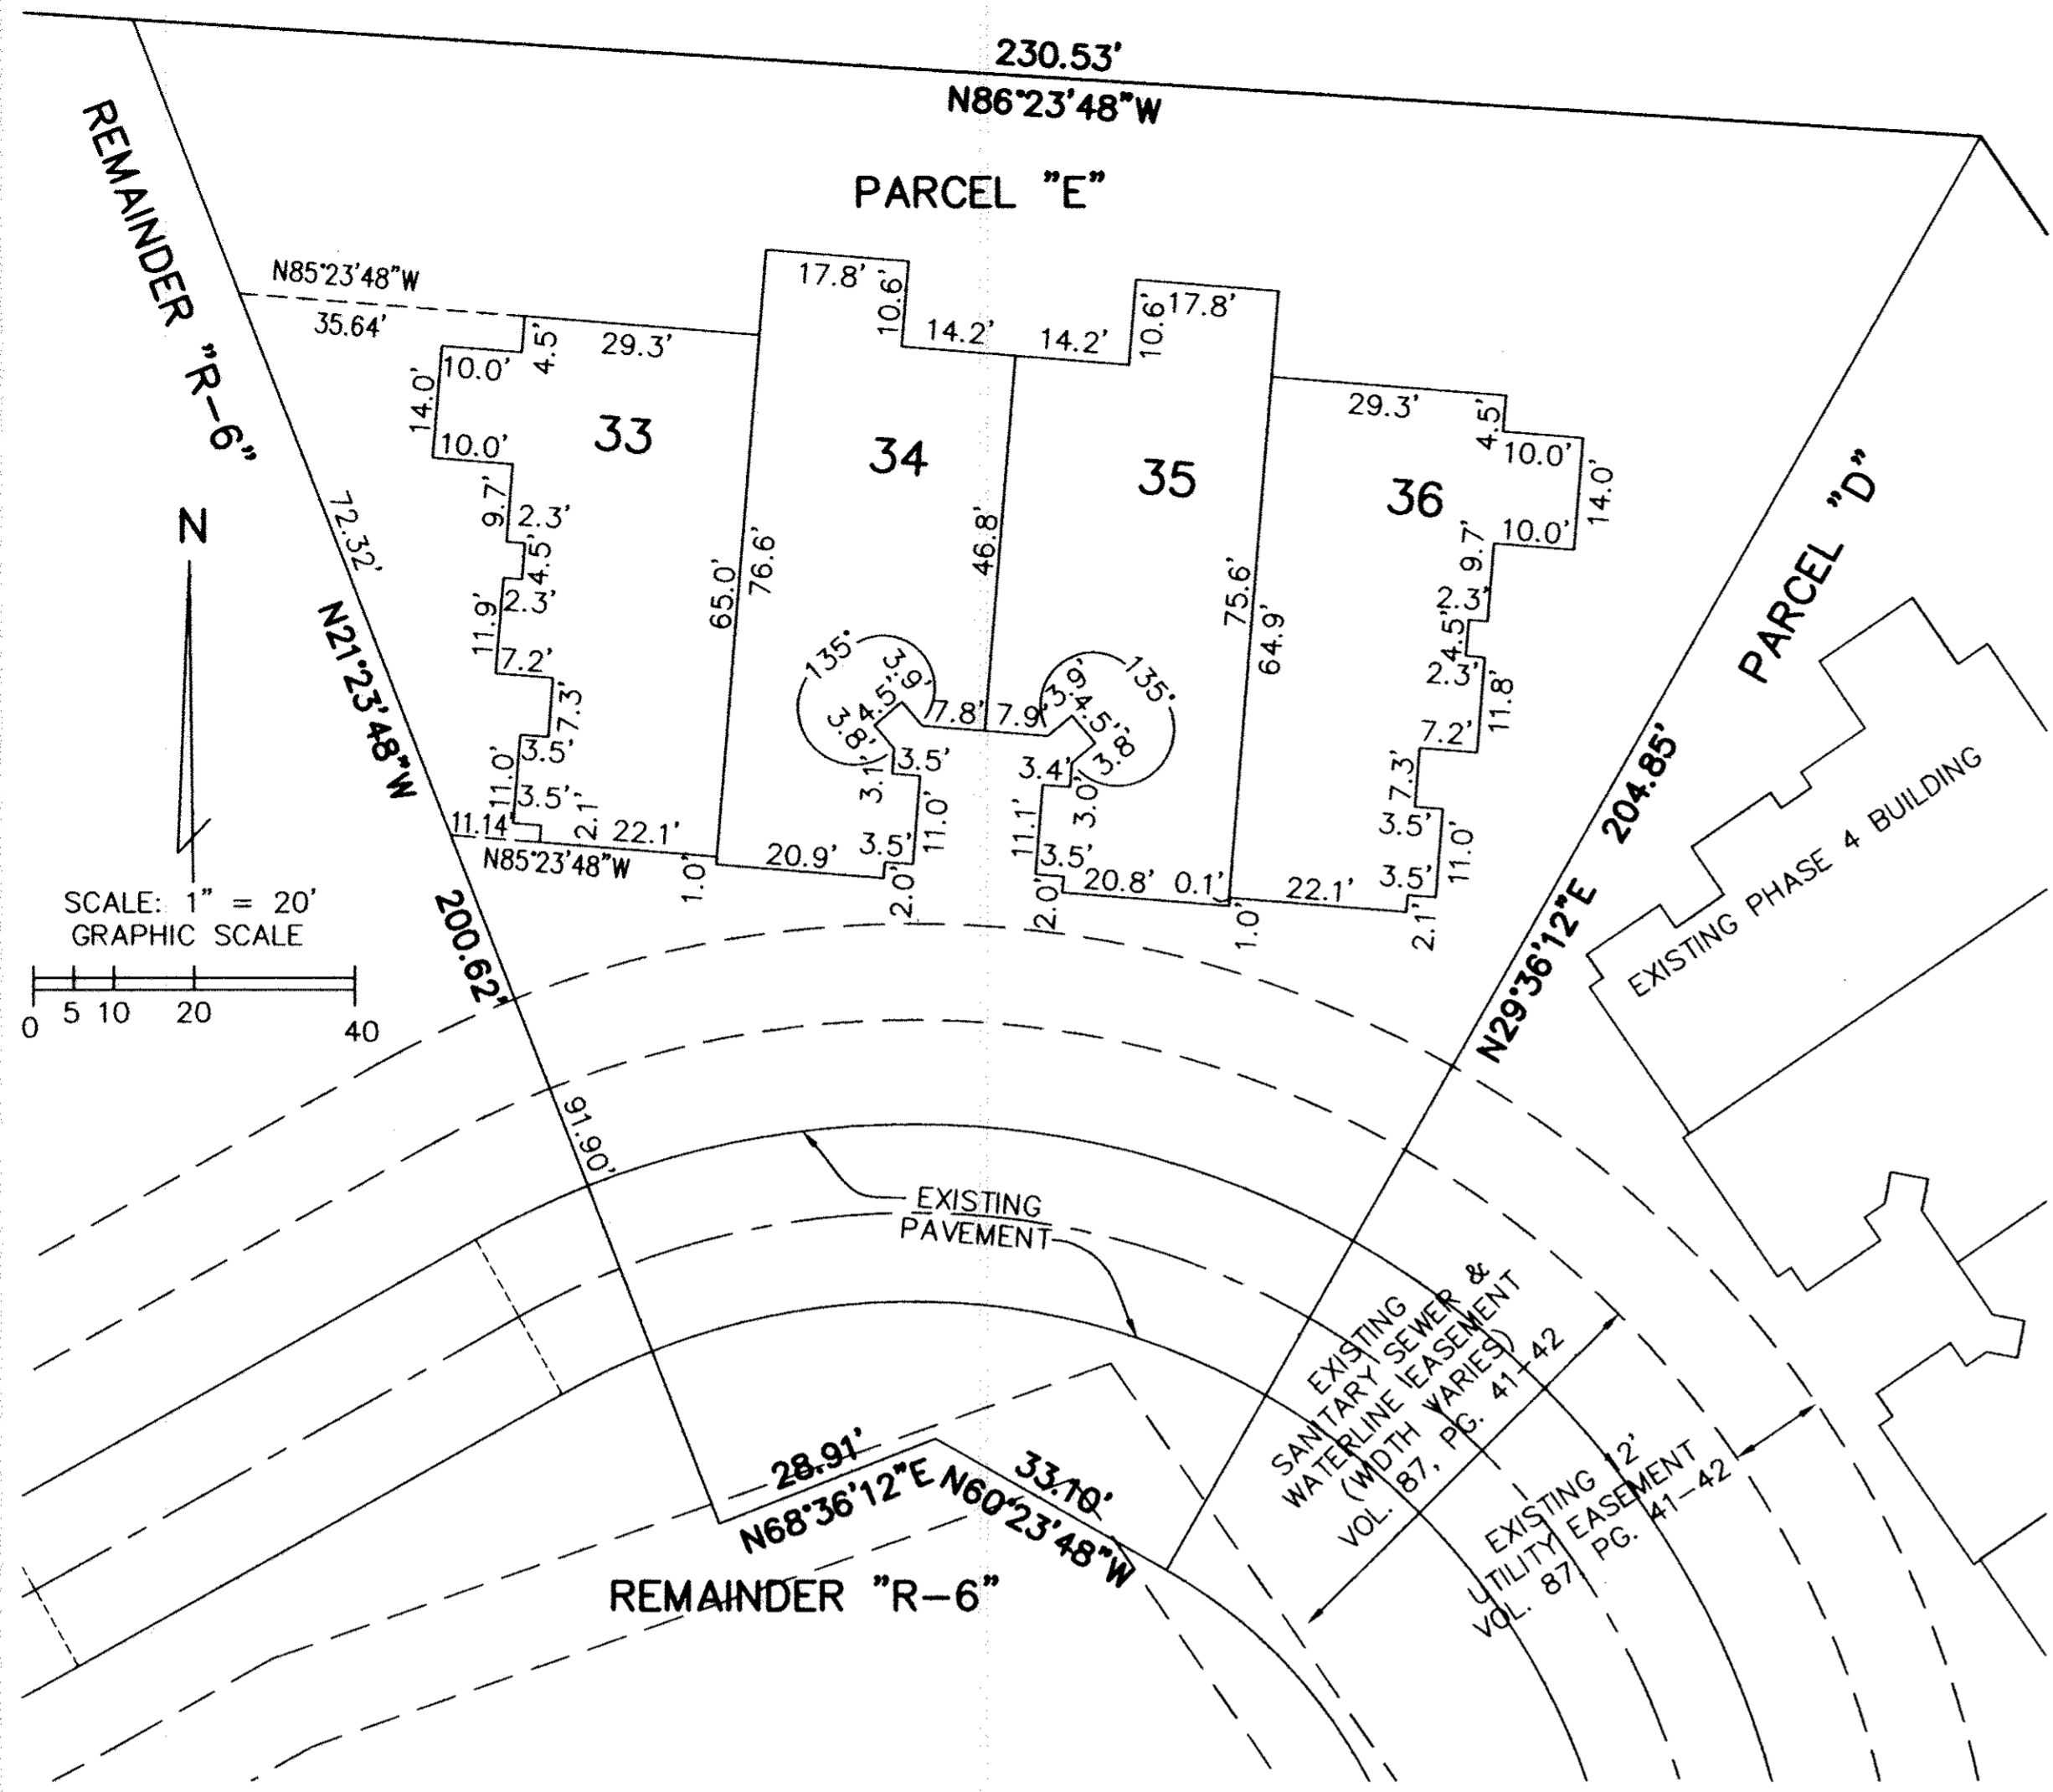

37-40 LEFT SIDE




37-40 FRONT

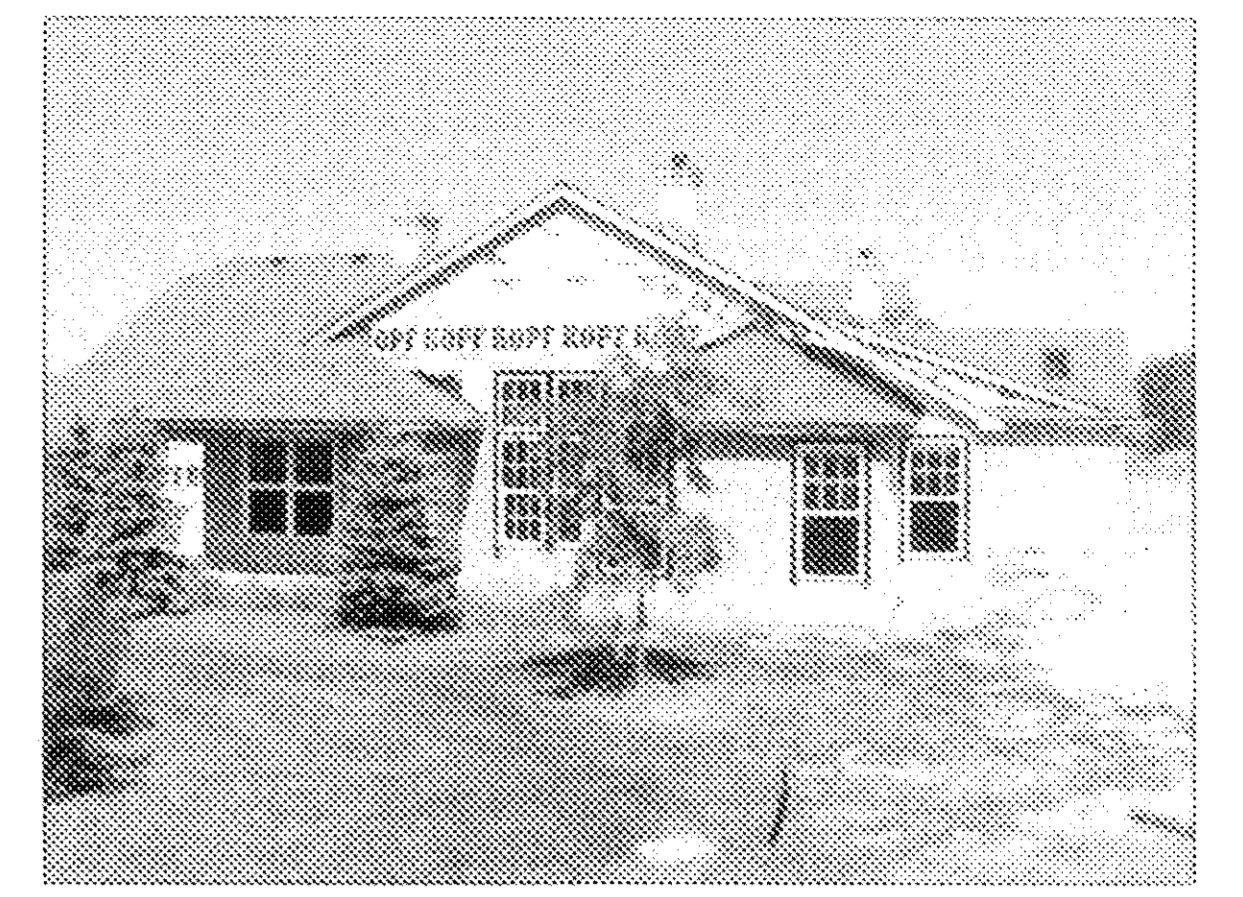


37-40 RIGHT SIDE




37-40 REAR

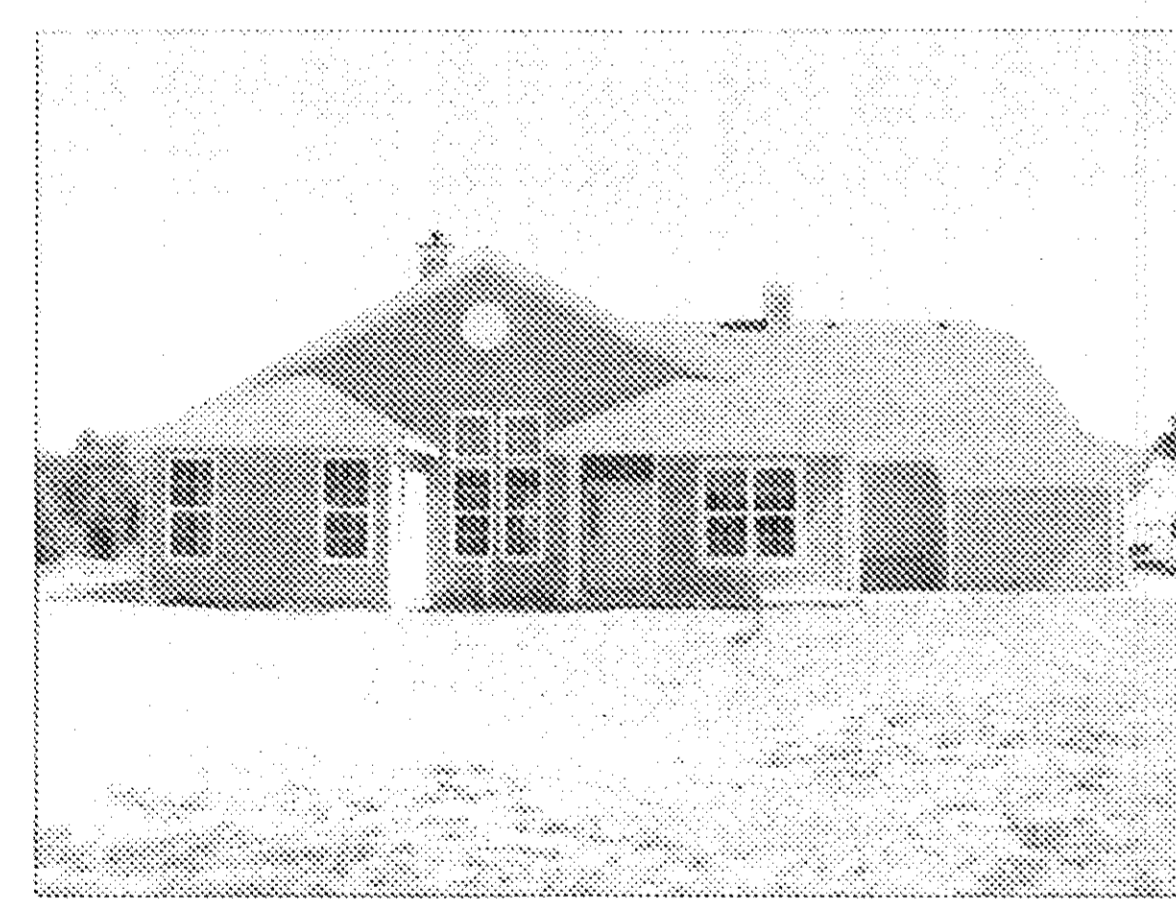


33-36 LEFT SIDE

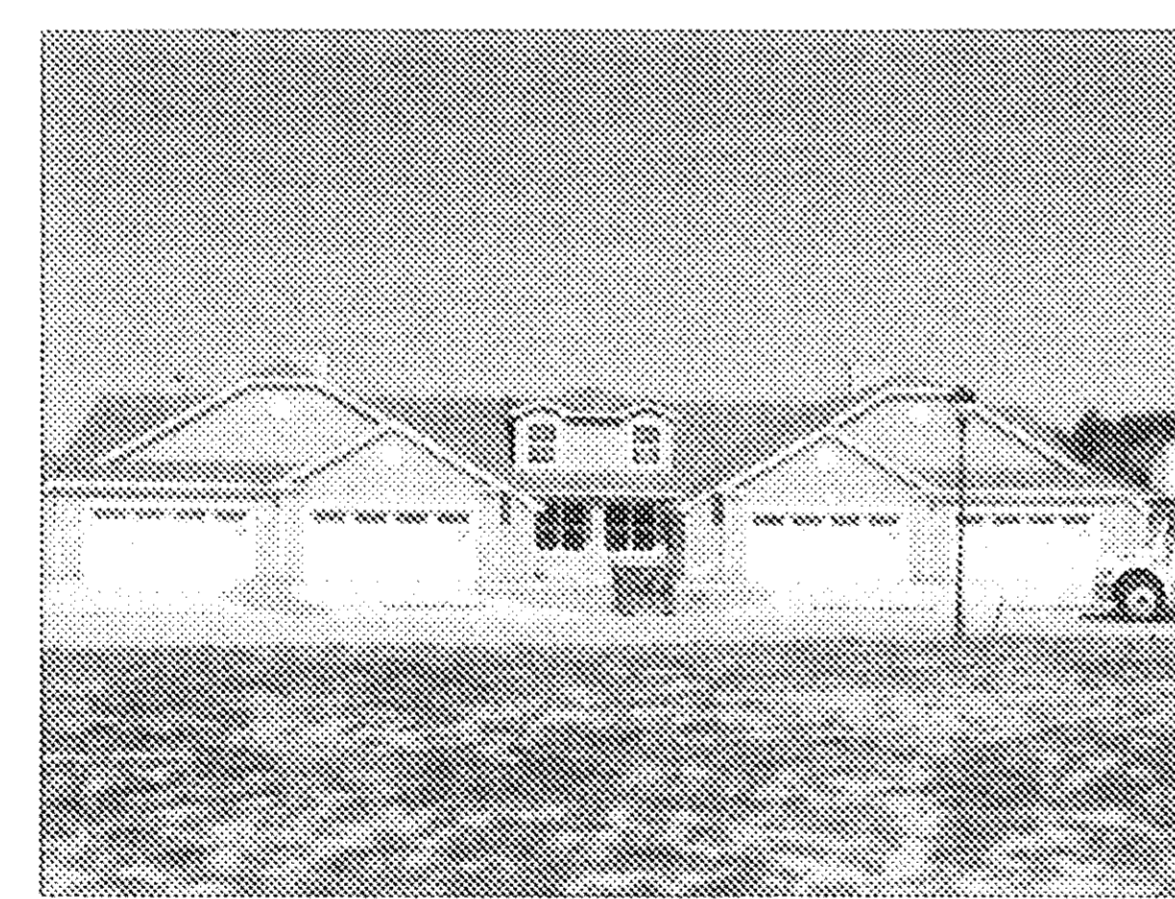

33-36 FRONT

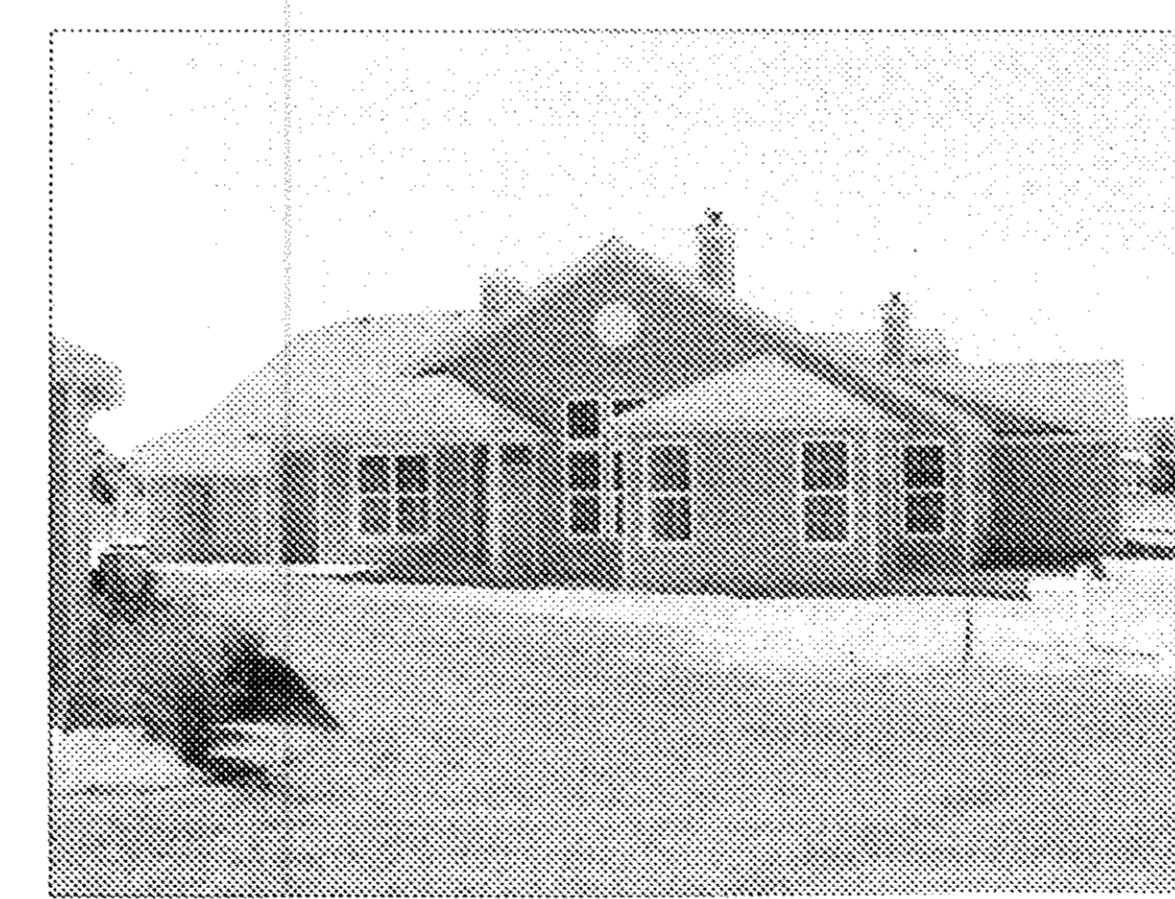

33-36 RIGHT SIDE

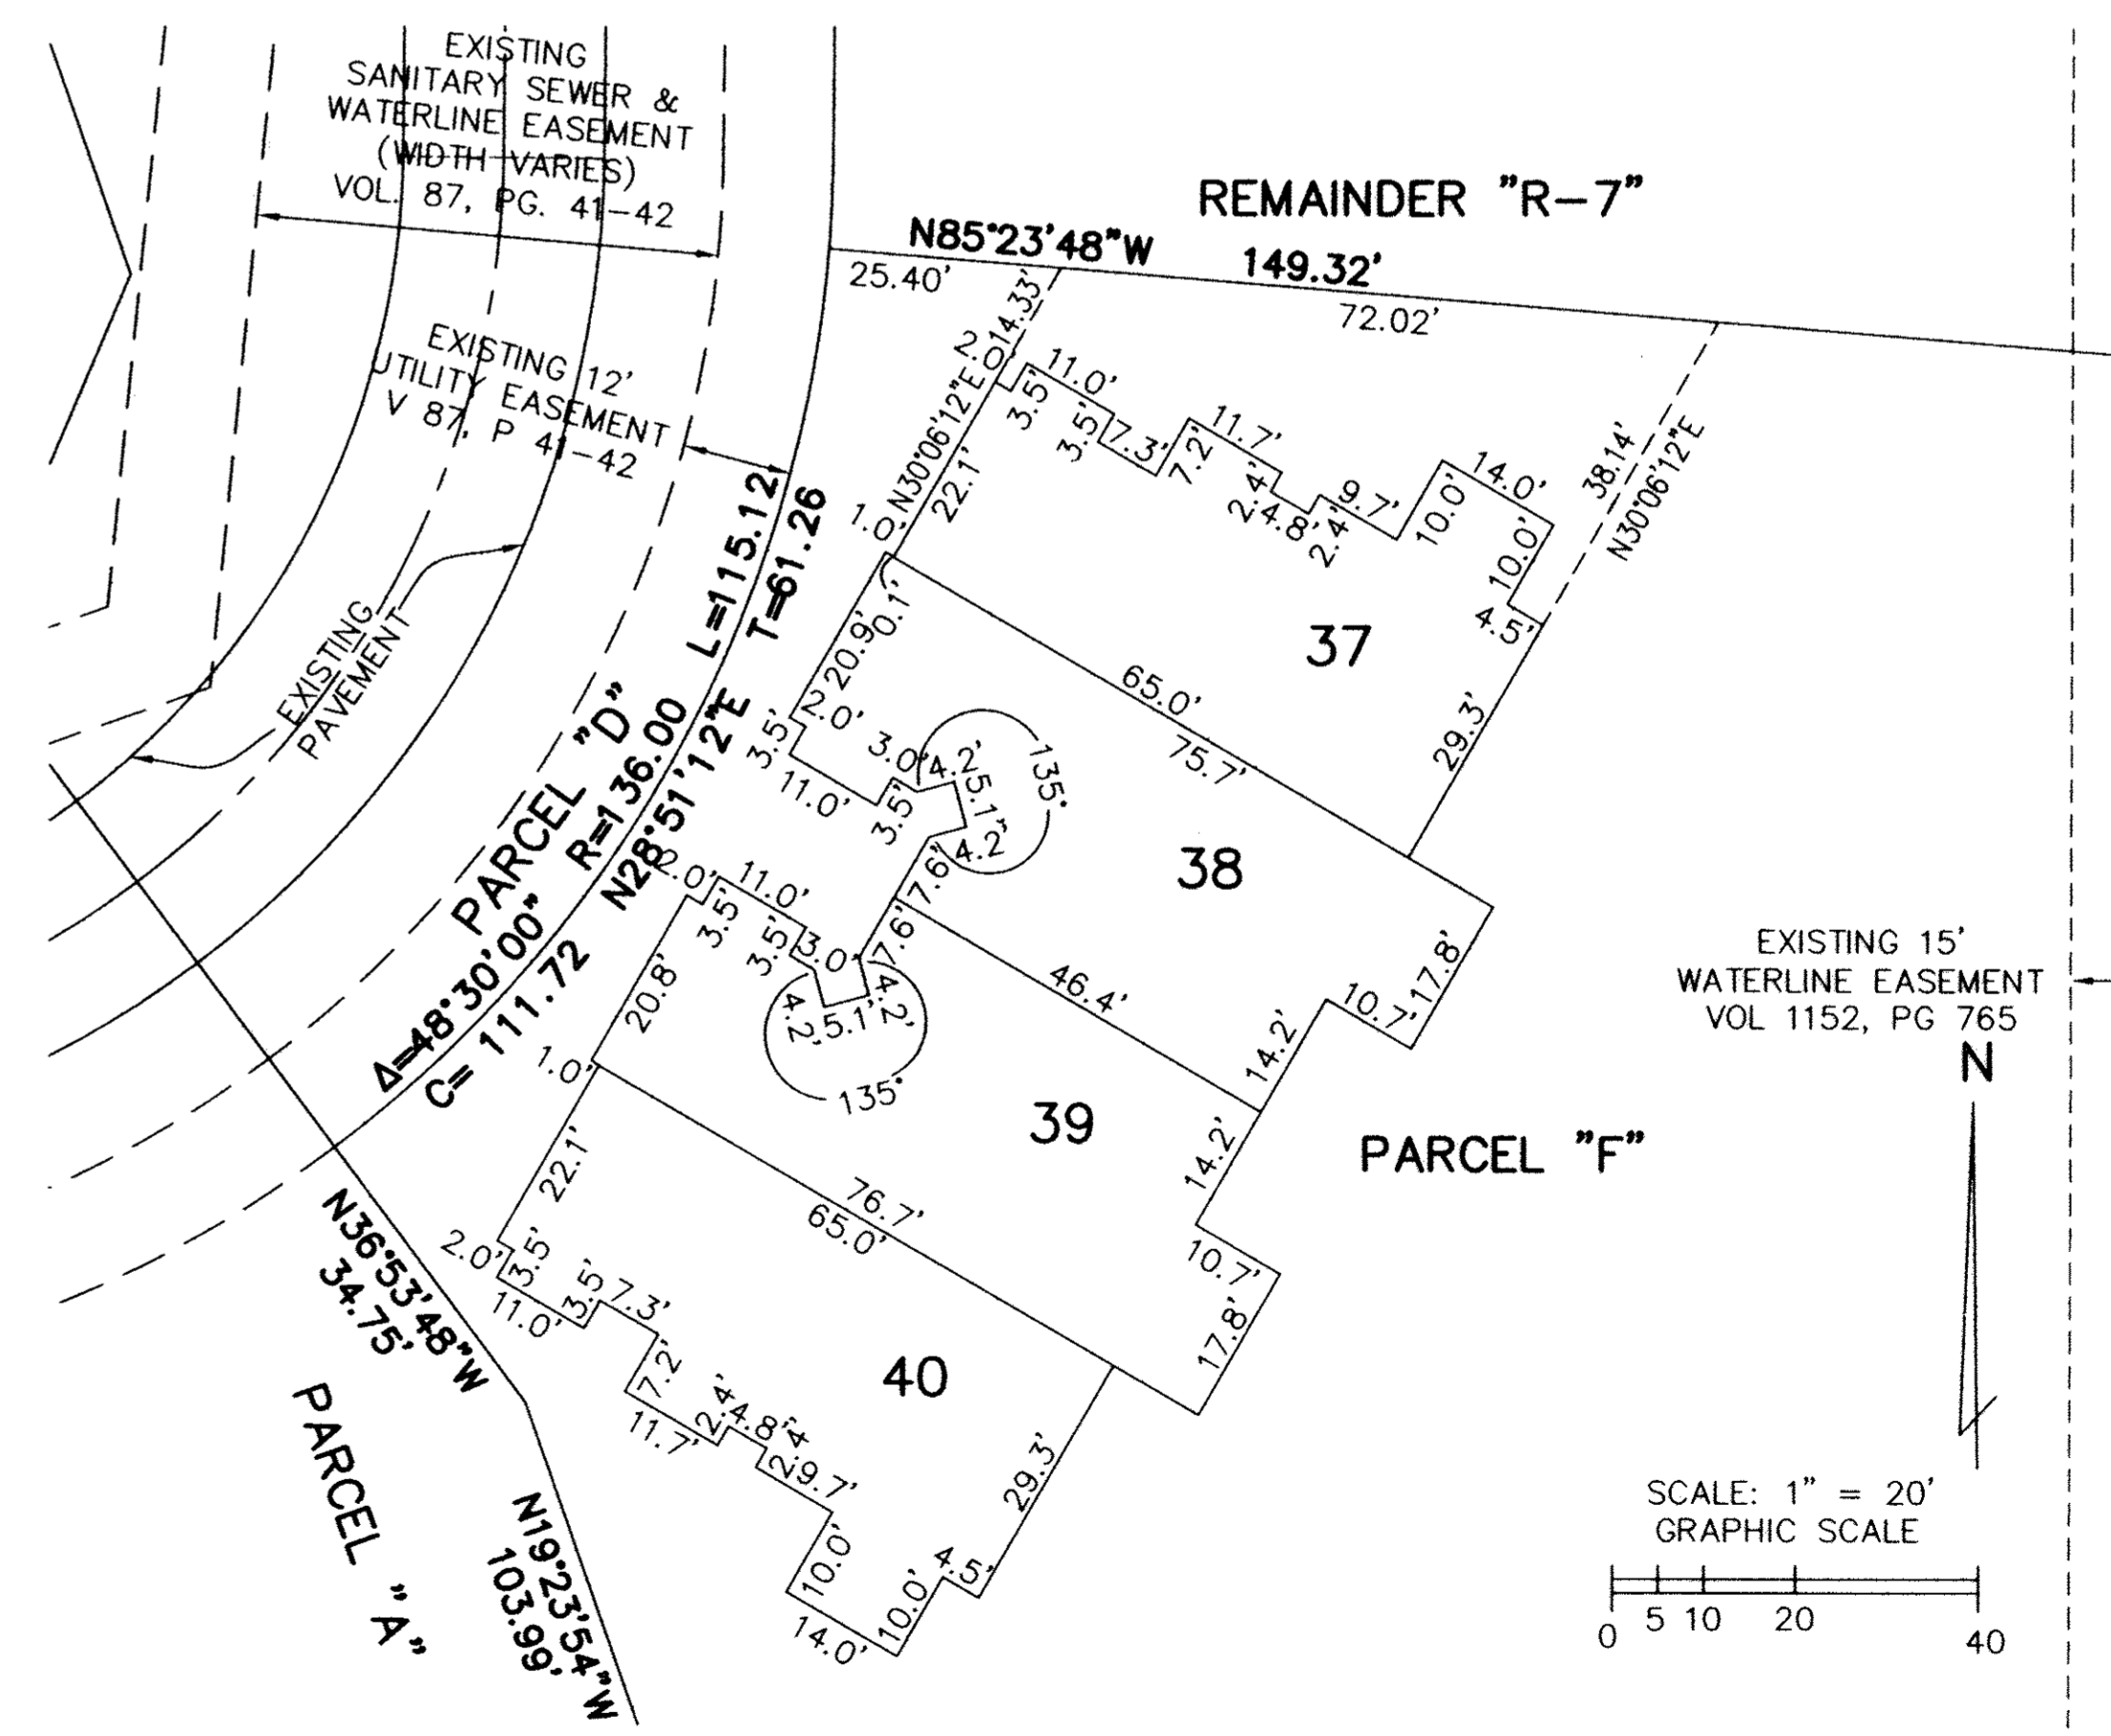

33-36 REAR

REVISIONS	DATE	DESCRIPTION

**WATERSIDE CROSSINGS SOUTH
CONDOMINIUM NO. 3 PHASE 5**
BEING PART BLOCK "K" OF THE WATERSIDE WEBBER
ROAD SUBD. RECORDED IN VOL. 87, PG. 41 & 42, IN
SEC. #8, CITY OF AVON LAKE, LORAIN COUNTY, OHIO

**THE HENRY G. REITZ
ENGINEERING COMPANY**
4214 ROCKY RIVER DRIVE
CLEVELAND, OHIO 44135
PHONE: (216) 251-3033

2 / 2
SEPTEMBER
2010

LNK LIMITED, INSTR# 20050092403
PPN 04-00-008-101-189

159.98' E
N 00°07'30" E

EXISTING 15'
WATERLINE EASEMENT
VOL 1152, PG 765

SCALE: 1" = 20'
GRAPHIC SCALE

L:\Drawings\K\WING-S\vac-condos-2.dwg, 1:20