


PLAT of the Project of Black River in the Township of Black River, Brown County and State of Ohio - State Standard 6 - inch

Dissected May 10th 1894 commencing at a stone
 where the E. of the north corner of the Public Square
 from which the plat is surveyed

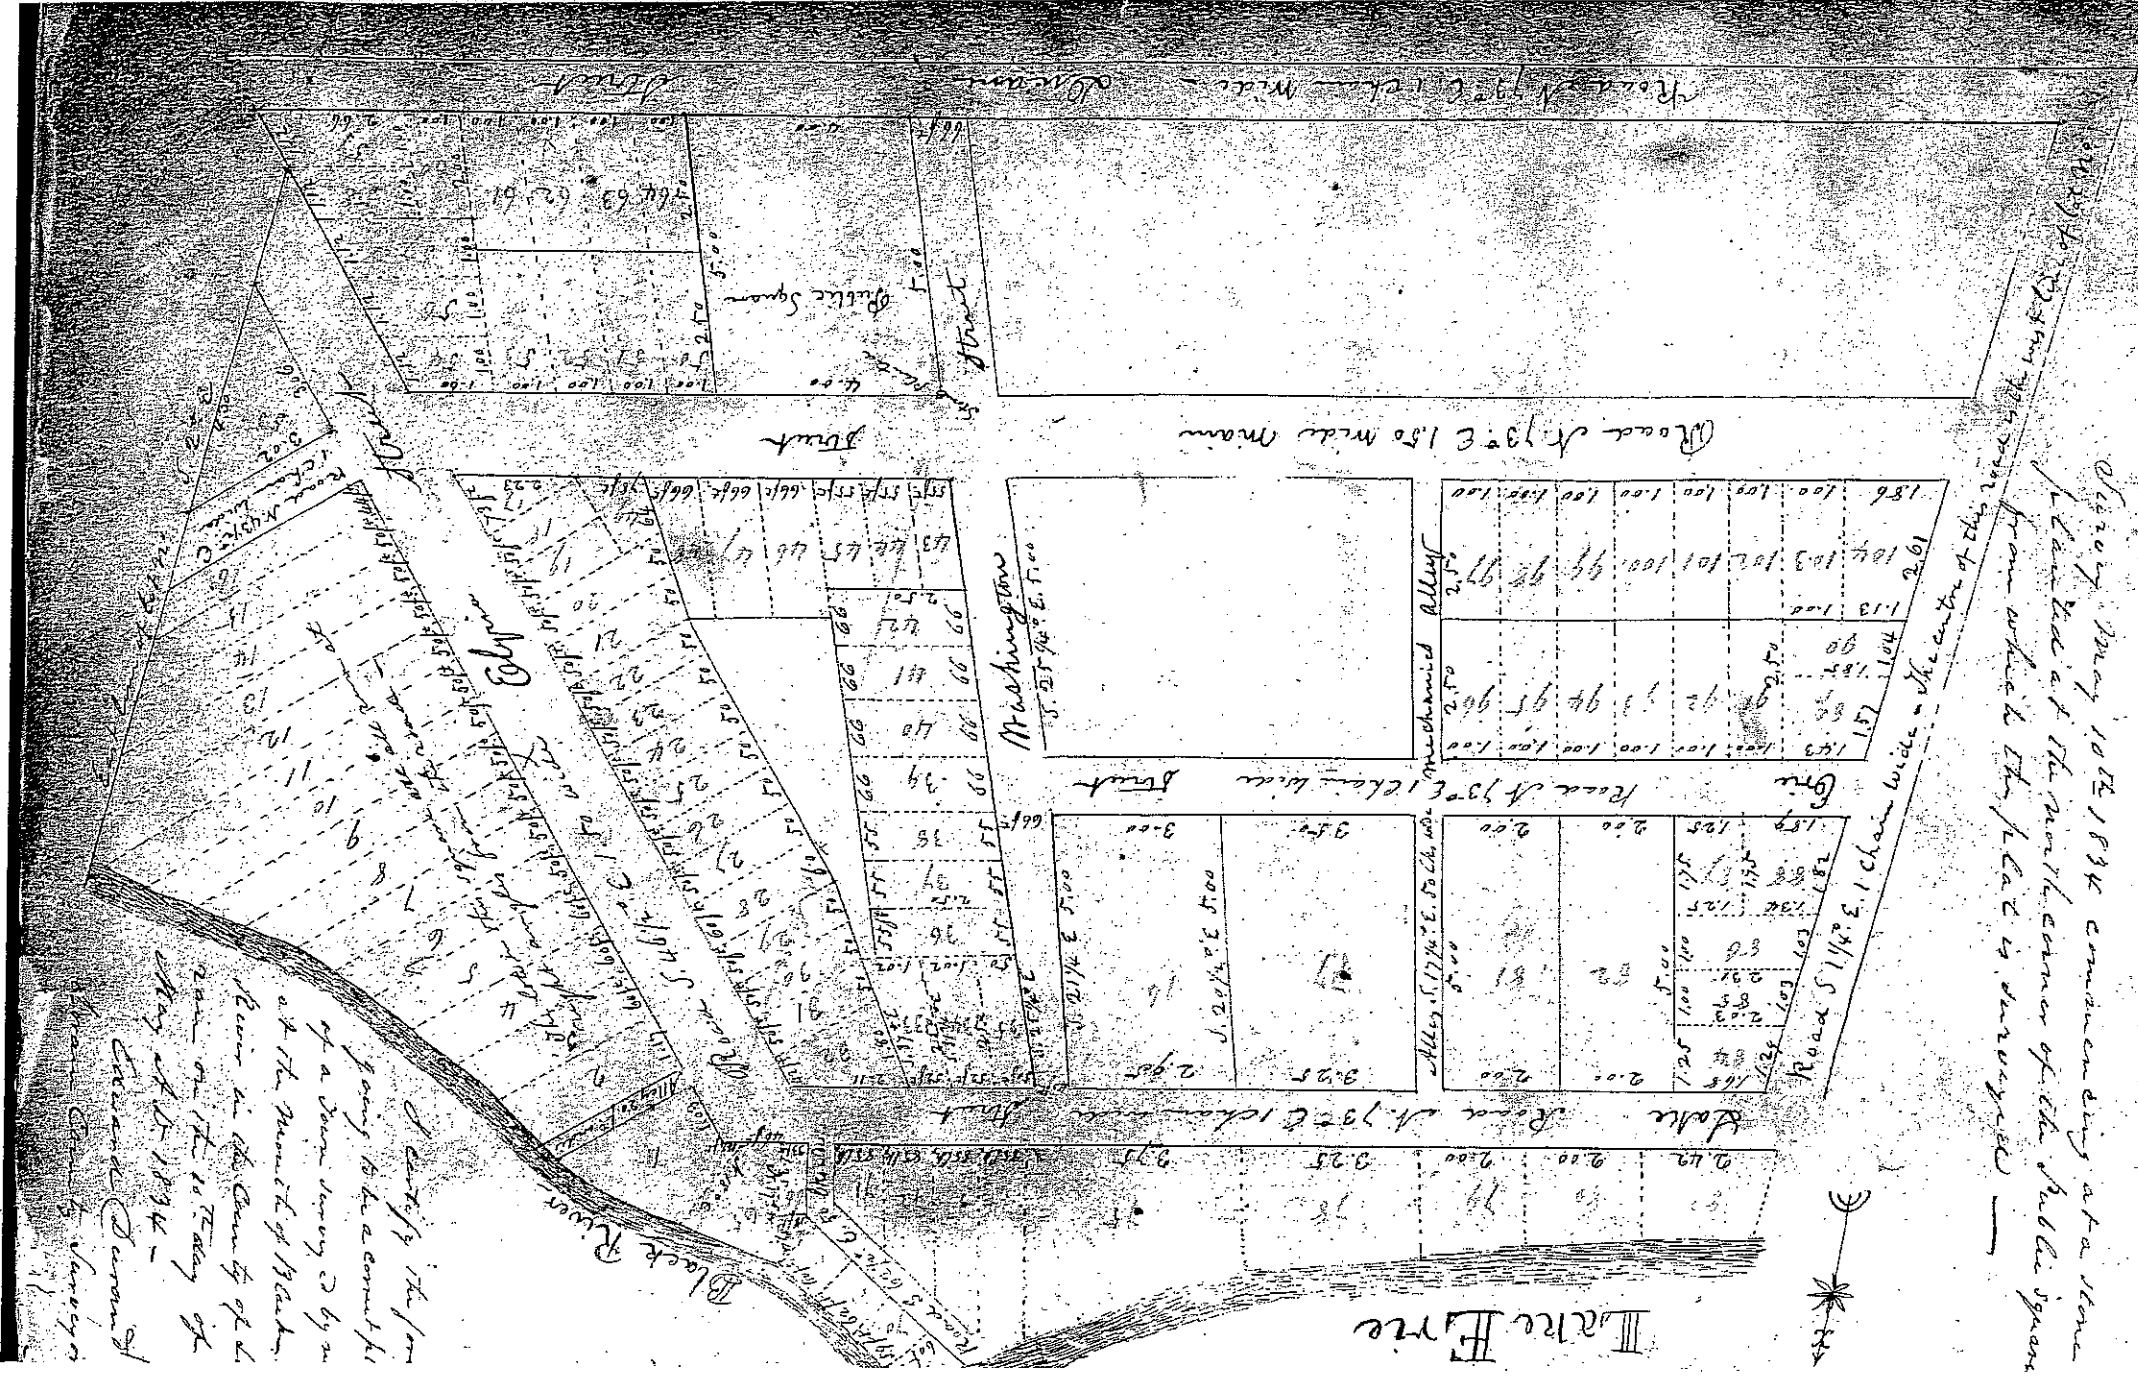

I certify the form
 given to be correct
 of a true survey 3 by 3
 at the mouth of Black
 River in the County of L
 June 10th 1894
 Surveyor
 Edwin

F-420

COPY