


# L702'

POINT # L702

LONG.	82-07-12.25112 W
LAT.	41-26-17.43613 N
ELEV.	638.881
EAST	2,072,671.38
NORTH	645,637.38

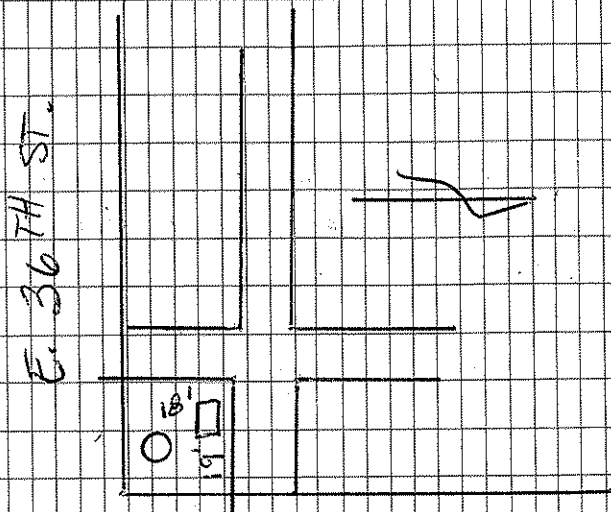

GROVE AVE.

(PT. 58)