


✓ L809

CAMBRIDGE + 39th ST.

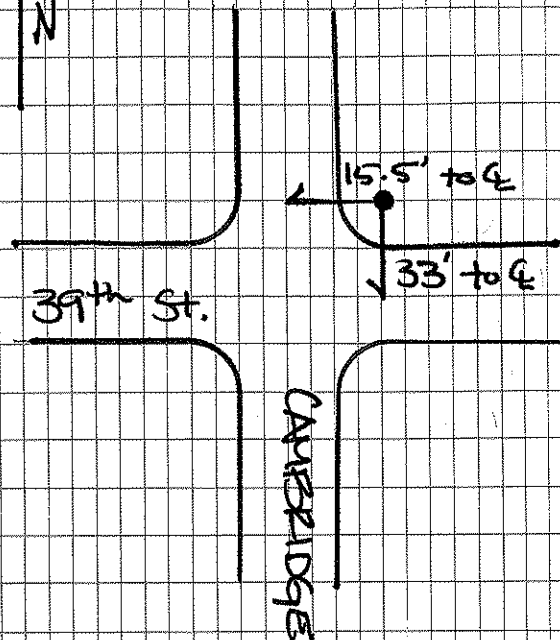

POINT: L809

LONG: 82° 12' 27.64635" W

LAT: 41° 26' 07.31110" N

ELEV: 610.682

EAST: 2048653.582

NORTH: 644520.031