

A

- 001  
34.36 A. #00418-D

APPROVED  
LORAIN CO.  
MAP DEPT.  
DATE 8/21/00  
SHEET 15-D  
BY T. SPILLMAN  
# 00418-D

PR. REF. DV 1166/456

- 002  
6.25 A.

1720.96

- 004  
17.65 A.

- 017  
28.63 A.

30

DEED CHECK  
15-00-030-000-011  
SURVEY BEFORE NEXT  
TRANSEER  
1075.20  
1072.52

Pt. - 011  
Pt. 24.00 A.

641.34

1579.13

1011 TO E

- 013  
9.47A.

Pt. - 011  
Pt. 24.00 A.

297  
302  
288.55  
- 012 .53A. 80  
288.55  
297

363  
- 010  
240  
2.00A.  
363

- 030  
4.69 A.

- 031  
4.73 A.



- 029  
5.39 A.

- 025  
5.43 A.

- 026  
5.43 A.

RD.

BIGGS RD.

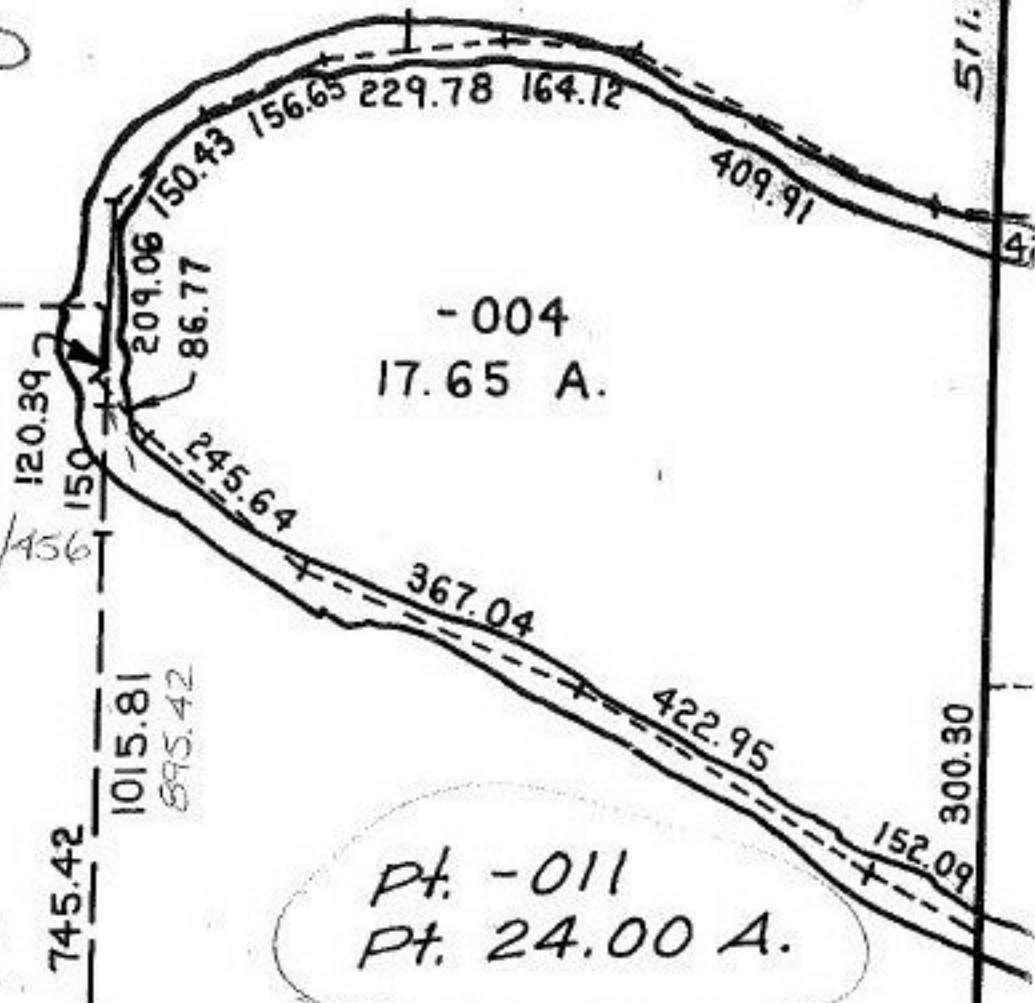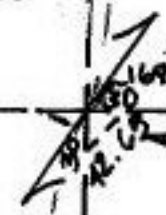

332.64

511.50

120.39

745.42

1015.81

895.42

169.985

199.985

1081

226.74

226.75

225.65

688.99

991.83

1027.57

1083.82

1046.84

608.46

808.46

RD. 226.77

(60)

266.00

266.60

226.77

226.76