

PARENT PARCEL: 18-00-040-000-007

CHILD PARCEL: 18-00-040-000-021 & -022

STARTING POINT: CL OF PITTS RD. & CL OF S.R. 18

NO. 00425-X

UNCOMBINATION

~~18-00-040-000-007~~
~~2.57 A.~~

18-00-040-000-021
1.50 A.

18-00-040-000-022
1.07 A.



PER DV 1228/905

SUVEY BEFORE NEXT TRANSFER

DEED CHECK

18-00-040-000-006
20.00 A.

SUVEY BEFORE NEXT TRANSFER

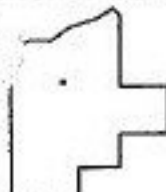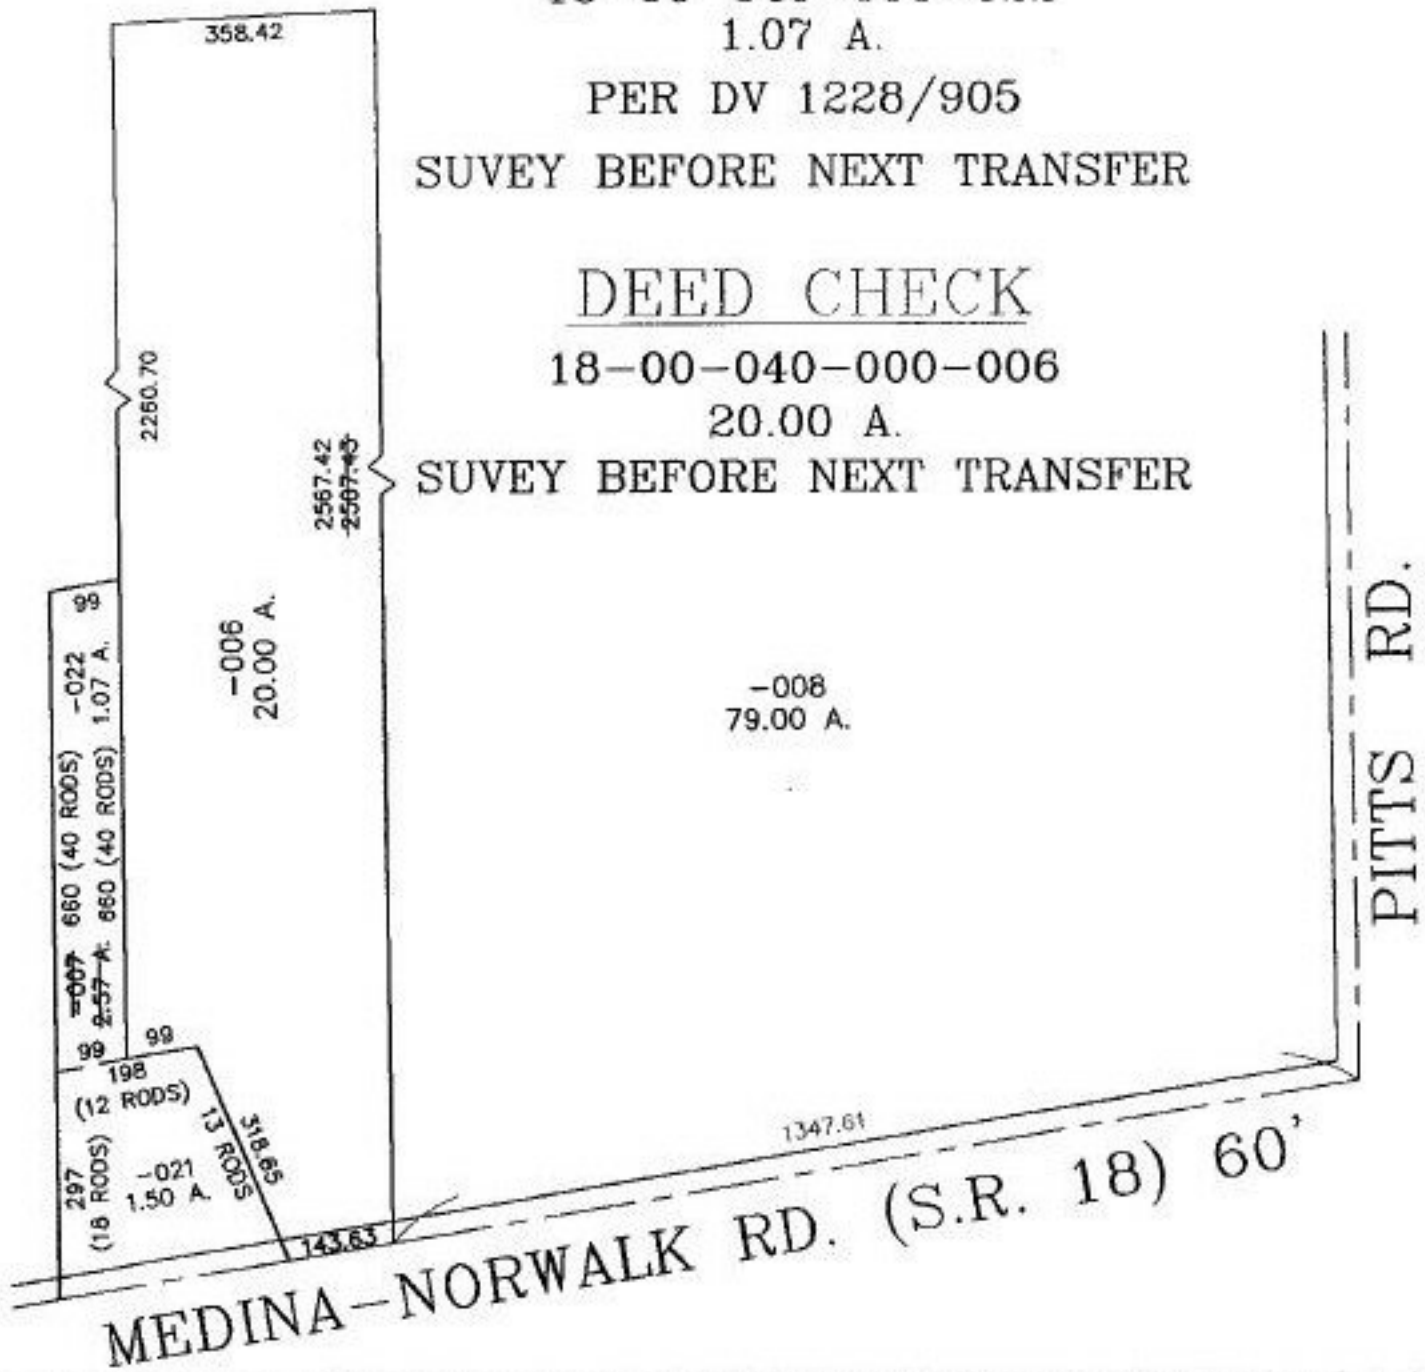

SPLITS/DEEDS PROCESSED
LORAIN COUNTY TAX MAP DEPARTMENT
226 MIDDLE AVE. ELYRIA, OHIO

SURVEYED BY: NONE
CLOSURE: NA
MAP PAGE(S): 55.59 : 10.000
APPROVED BY: T. SPILLMAN DATE: 09/01/00
SCALE: 1" = 300' PRIOR INSTRUMENT: DV 1228/905