

PARENT PARCEL: 14-00-125-000-010 & -012

CHILD PARCEL: XX-XX-XXX-XXX-XXX

STARTING POINT: S.W. CORNER OF O.L. 125

NO. 00430-A

# ACREAGE CORRECTION

14-00-125-000-010

~~23.43 A.~~

23.39 A.

14-00-125-000-012


~~17.35 A.~~

17.91 A.

AC. CORR. PER SURV.  
RODGER G. SIMON



ASHLAND-OBERLIN RD. (S.R. 58)

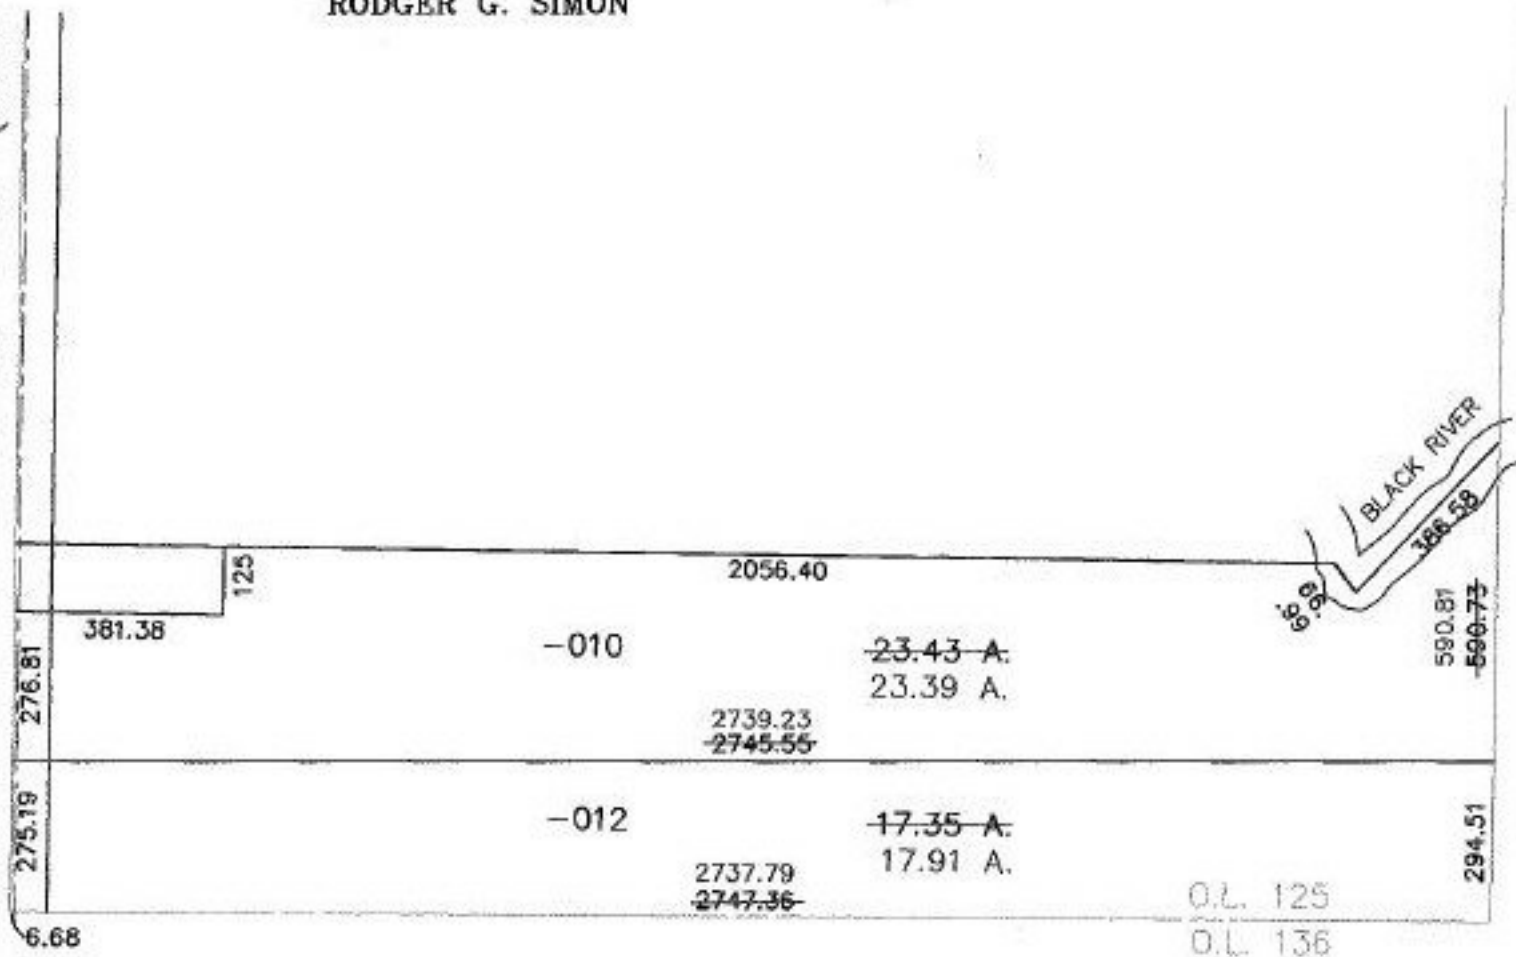

**SPLITS/DEEDS PROCESSED**  
LORAIN COUNTY TAX MAP DEPARTMENT  
226 MIDDLE AVE. ELYRIA, OHIO

SURVEYED BY: RODGER G. SIMON  
CLOSURE: 0.01 : 10,000  
MAP PAGE(S): 14-G  
APPROVED BY: TJS DATE: 09/11/00  
SCALE: 1" = 400' PRIOR INSTRUMENT: OR 1201/753