

PARENT PARCEL: 15-00-031-000-003

CHILD PARCEL: XX-XX-XXX-XXX-XXX

STARTING POINT: MON. BOX, CL OF BIGGS RD. & CL OF INDIAN HOLLOW RD.

NO. 00437-D


DEED CHECK

15-00-031-000-003

74.56 A.

PROPOSED SPLIT

NEEDS TO BE SUBMITTED AS A SPLIT

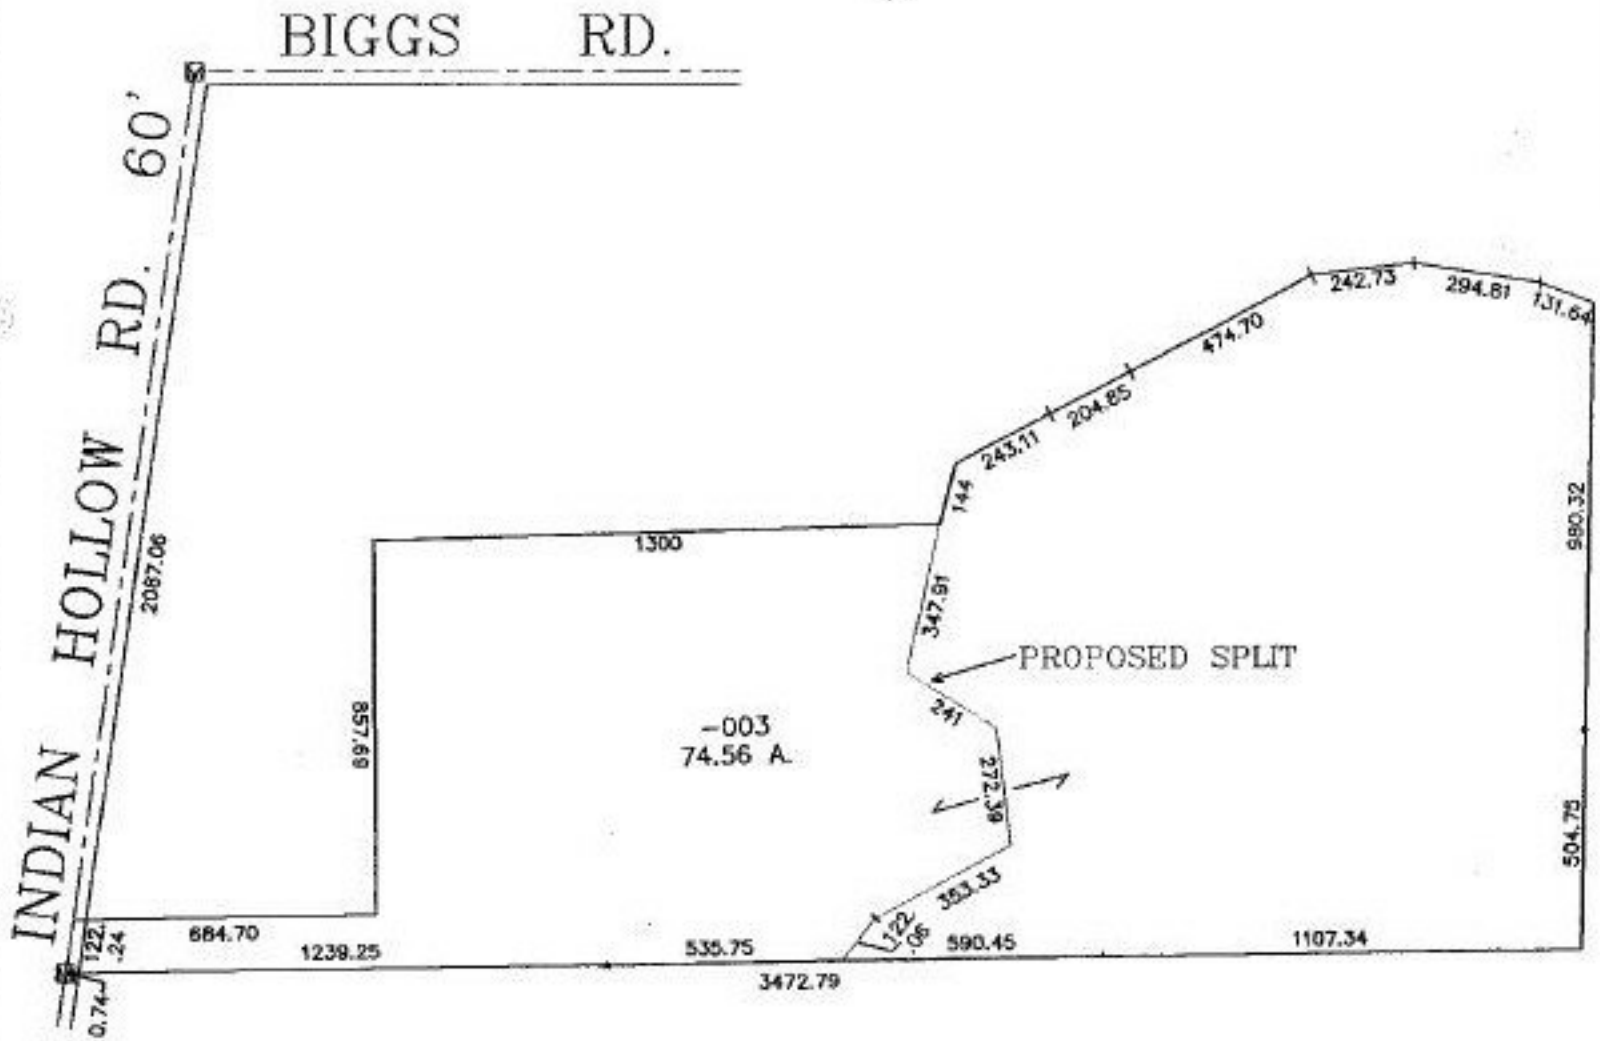

SPLITS/DEEDS PROCESSED

LORAIN COUNTY TAX MAP DEPARTMENT
226 MIDDLE AVE. ELYRIA, OHIO

SURVEYED BY: CHARLES W. FLANIGAN JR.
 CLOSURE: 0.047 : 10.000
 MAP PAGE(S): 15-D, 15-00-031-A & B
 APPROVED BY: TJS DATE: 09/18/00
 SCALE: 1" = 100' PRIOR INSTRUMENT: 980564999