

PARENT PARCEL: 18-00-021-114-001, -002, & -004


CHILD PARCEL: XXXXXXXXXXXX

STARTING POINT: NORTH R.O.W. OF HAMILTON ST. & EAST R.O.W. OF BARKER ST.

NO. 00442-D

# DEED CHECK

18-00-021-114-001	DEED MISSING A COURSE	NO TRANSFER
18-00-021-114-002	DEED MISSING A COURSE	NO TRANSFER
18-00-021-114-004	DEED MISSING A COURSE	NO TRANSFER

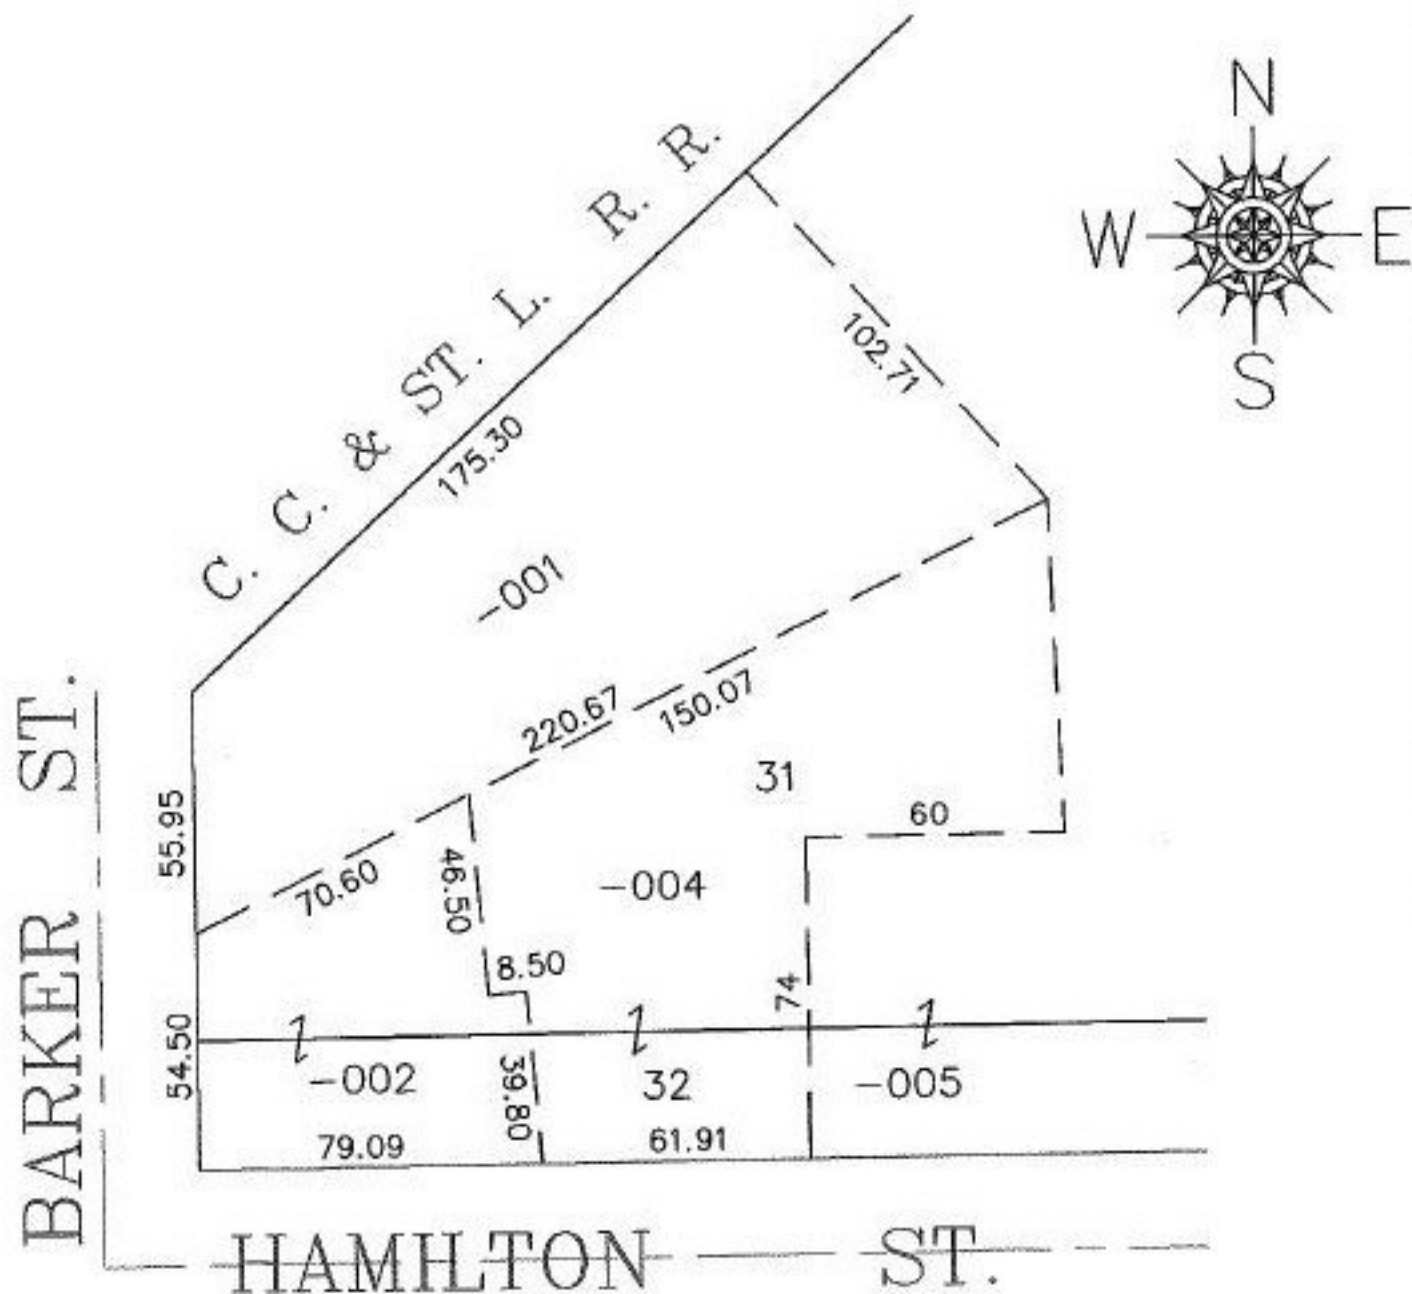

**SPLITS/DEEDS PROCESSED**  
 LORAIN COUNTY TAX MAP DEPARTMENT  
 226 MIDDLE AVE. ELYRIA, OHIO

SURVEYED BY: NONE  
 CLOSURE: CAN'T RUN  
 MAP PAGE(S): 18-00-021-C  
 APPROVED BY: TJS DATE: 10/03/00  
 SCALE: 1" = 50' PRIOR INSTRUMENT: DV 756/28