


PARENT PARCEL: 18-00-043-000-023

CHILD PARCEL: XX-XX-XXX-XXX-XXX

STARTING POINT: CL OF PECK-WADSWORTH & CL OF QUARRY RD.

NO. 00446-D

MAP CORR. ONLY

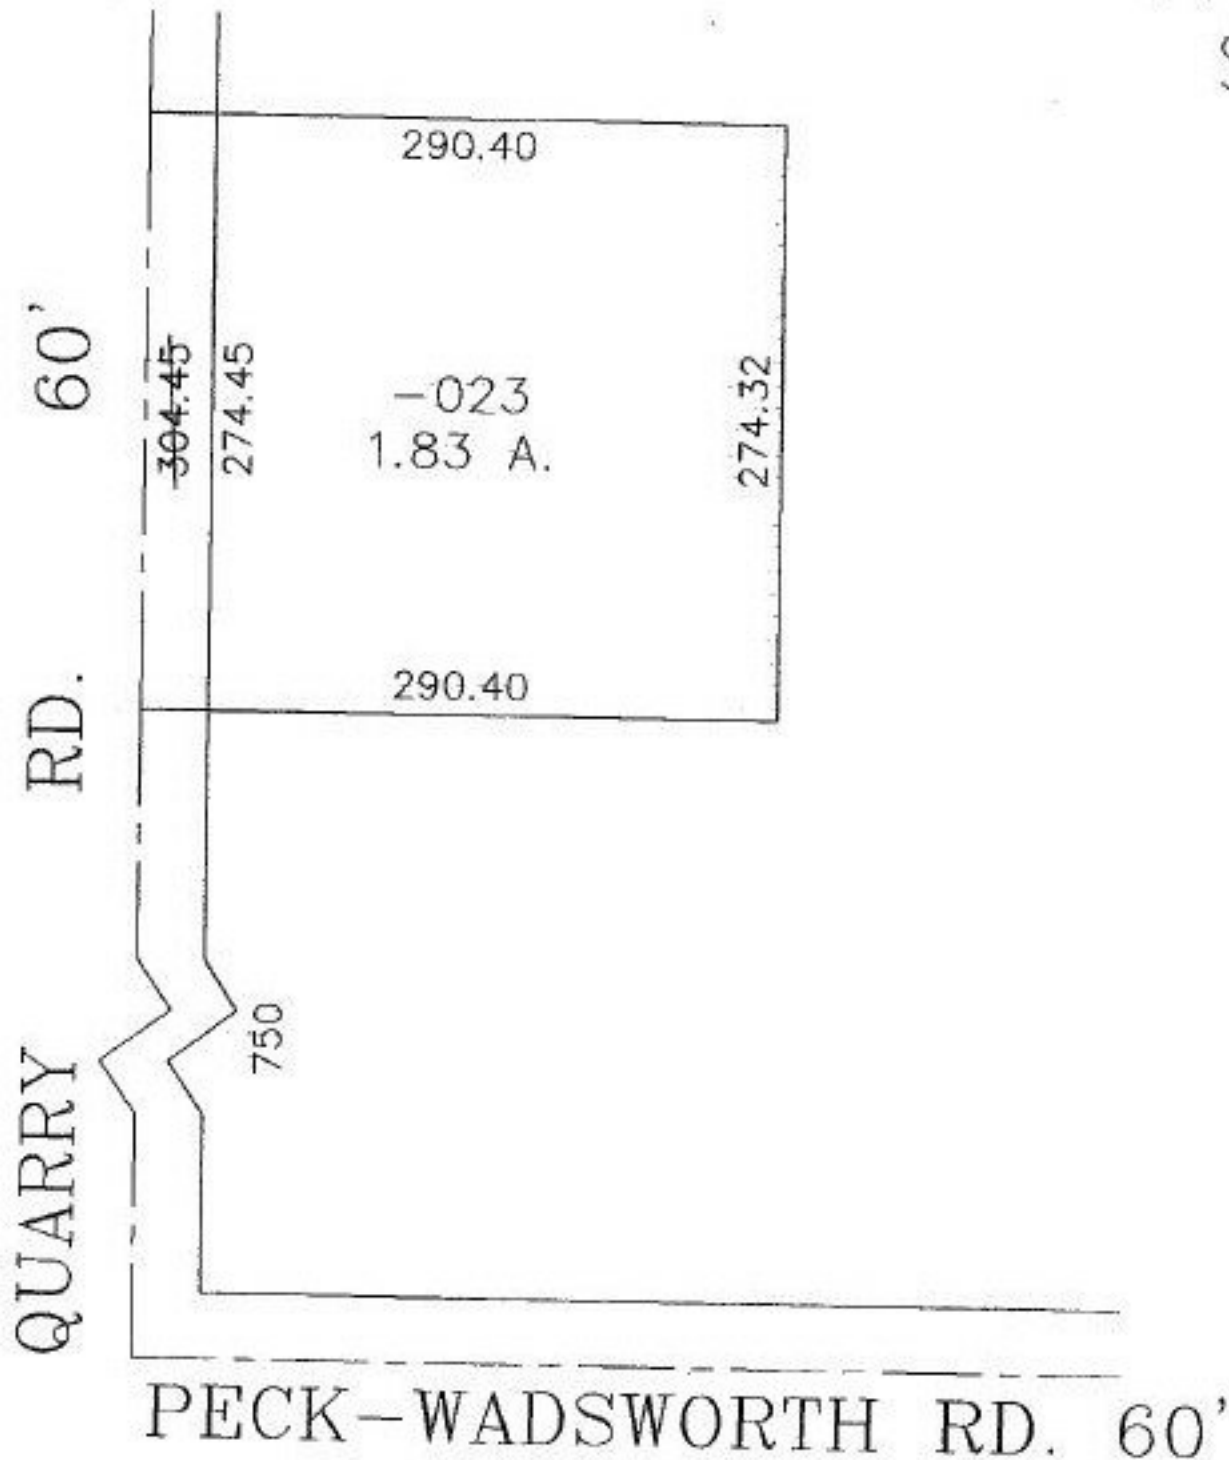

SPLITS/DEEDS PROCESSED

LORAIN COUNTY TAX MAP DEPARTMENT
226 MIDDLE AVE. ELYRIA, OHIO

SURVEYED BY: NONE

CLOSURE: 0.76 : 10,000

MAP PAGE(S): 18-00-043-C

APPROVED BY: TJS DATE: 12/15/00

SCALE: 1" = 100' PRIOR INSTRUMENT: 20000708593