


PARENT PARCEL: 12-00-015-000-055

CHILD PARCEL: 12-00-015-000-076 THRU -078

STARTING POINT: CL OF BOONE RD. & S.W. CORNER OF LAND CONVEYED TO FRED CVRK

NO. 00449-U

ELYRIA-TWINSBURG RD. 60'

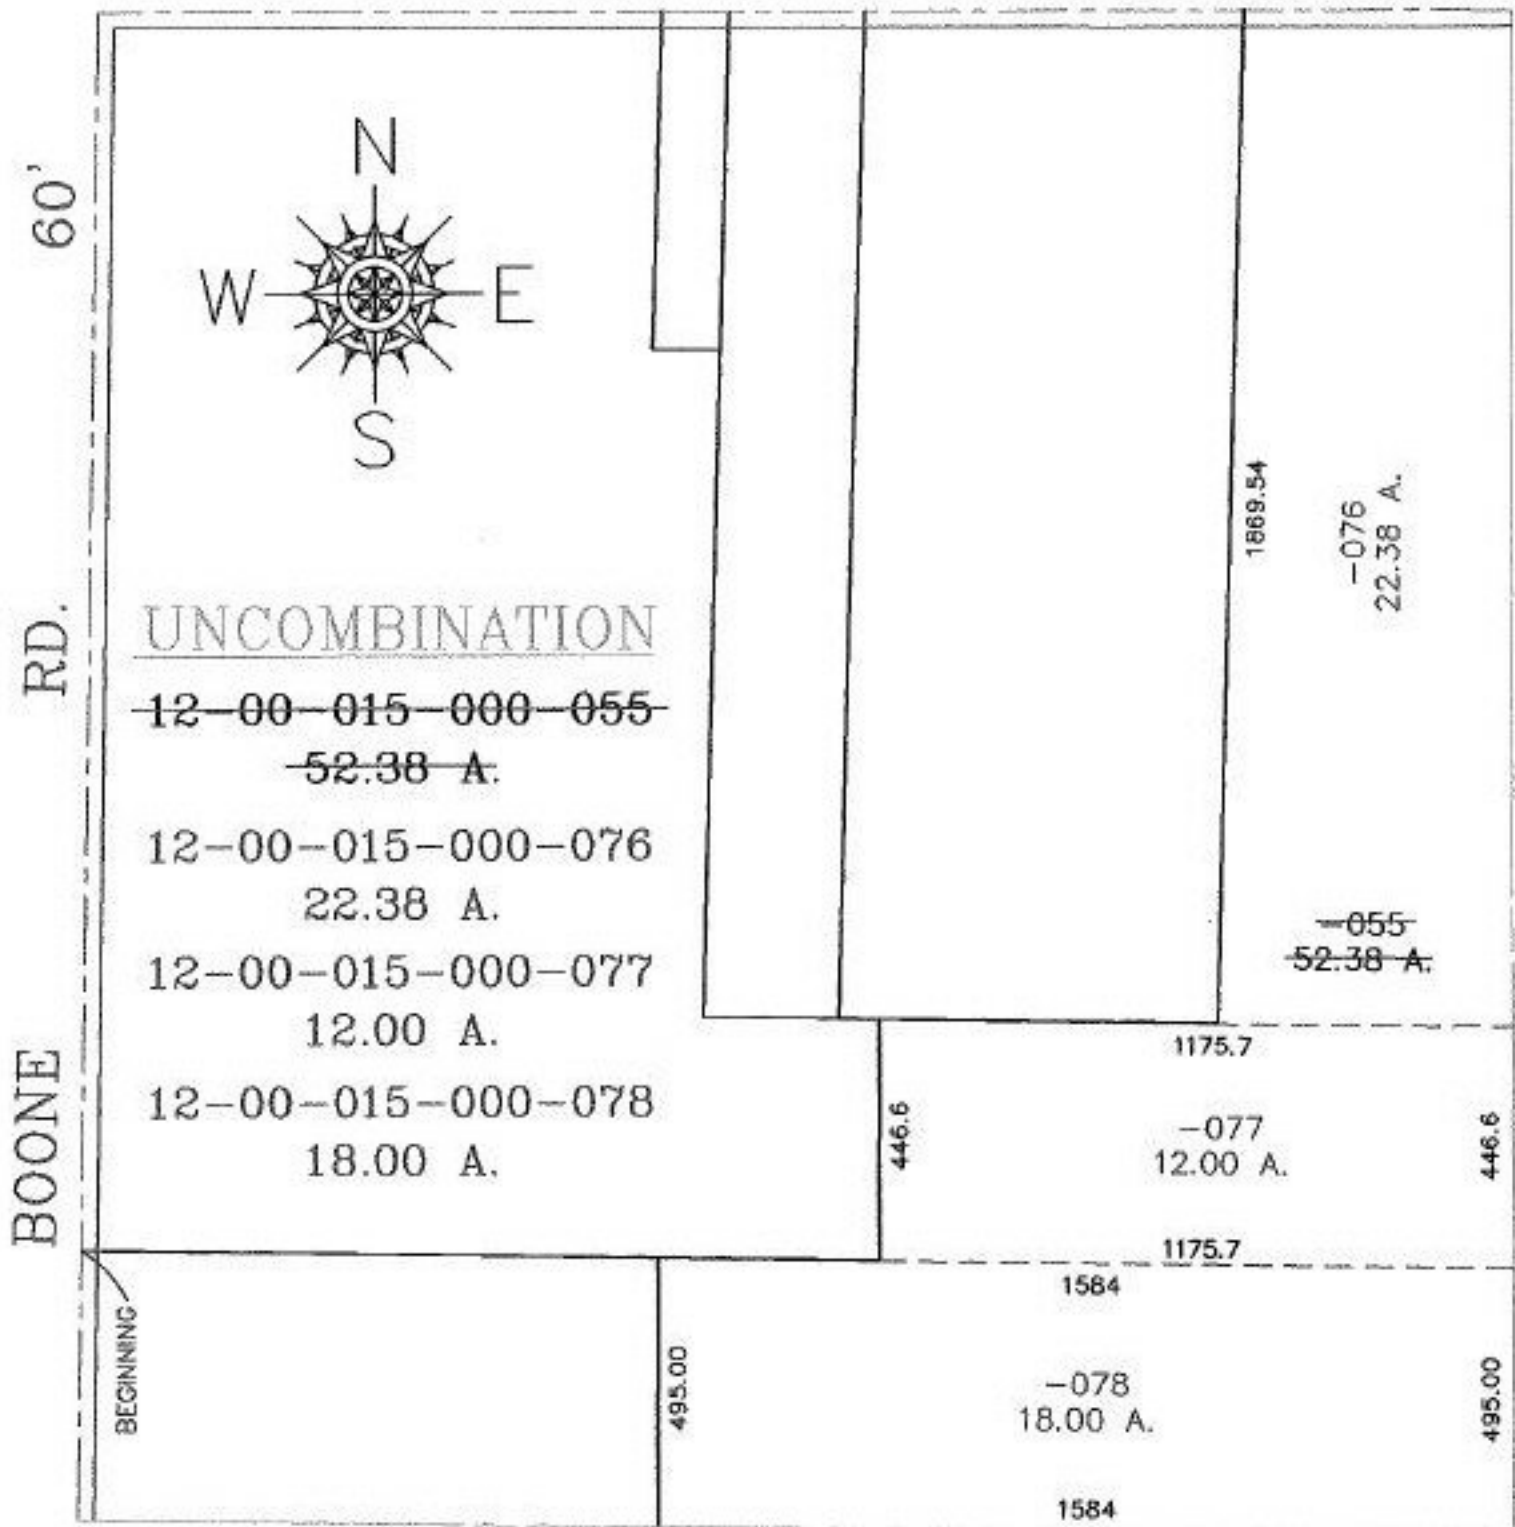

SPLITS/DEEDS PROCESSED
 LORAIN COUNTY TAX MAP DEPARTMENT
 226 MIDDLE AVE. ELYRIA, OHIO

SURVEYED BY: NONE
 CLOSURE: CAN'T RUN
 MAP PAGE(S): 12-00-015-A & B
 APPROVED BY: TJS DATE: 11/17/00
 SCALE: 1" = 400 PRIOR INSTRUMENT: 20000702963