

PARENT PARCEL: 09-00-001-102-022

CHILD PARCEL: XX-XX-XXX-XXX-XXX

STARTING POINT: CL OF CHURCH ST. & CL OF QUARRY RD.

NO. 00450-D

# ACREAGE CORRECTION

09-00-001-102-022

~~0.49~~ A.

0.51 A.

AC. CORR. PER SURV.  
VINCENT C. McGERVEY



DETAIL  
NO SCALE




CHURCH ST.

60'

QUARRY RD.

AMHERST TWP. O.L. 91  
RUSSIA TWP. O.L. 1

RUSSIA TWP. O.L. 2

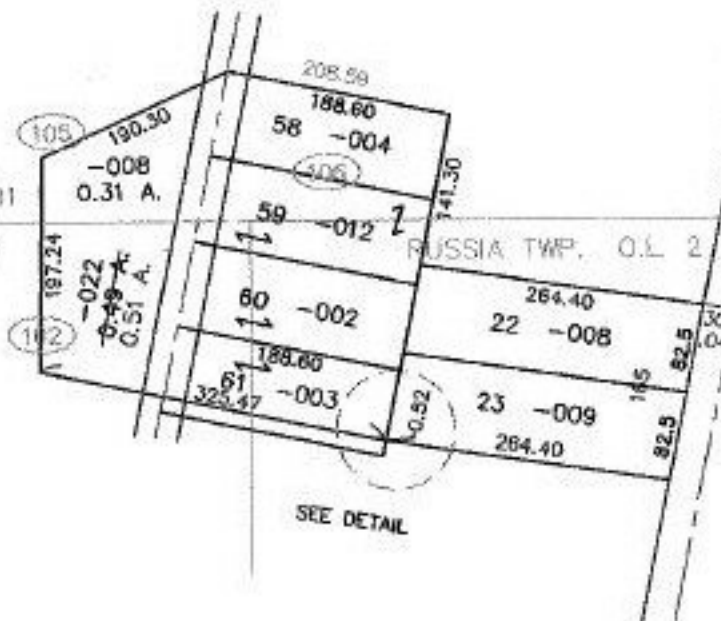

SEE DETAIL

MAP PAGE(S): 9-00-001-B, 9-00-002-A, 5-00-091-B



## SPLITS/DEEDS PROCESSED

LORAIN COUNTY TAX MAP DEPARTMENT  
226 MIDDLE AVE. ELYRIA, OHIO

SURVEYED BY: VINCENT C. McGERVEY

CLOSURE: 0.02 : 10,000

APPROVED BY: TJS DATE: 10/23/00

SCALE: 1" = 200 PRIOR INSTRUMENT: DV 1275/444