


PARENT PARCEL: 04-00-012-103-136, & -137
CHILD PARCEL: 04-00-012-103-167, & -168
STARTING POINT: CENTERLINE OF STONEY RIDGE RD. & MILLS RD.

NO. 00452-C



PARCEL NUMBER CORRECTION

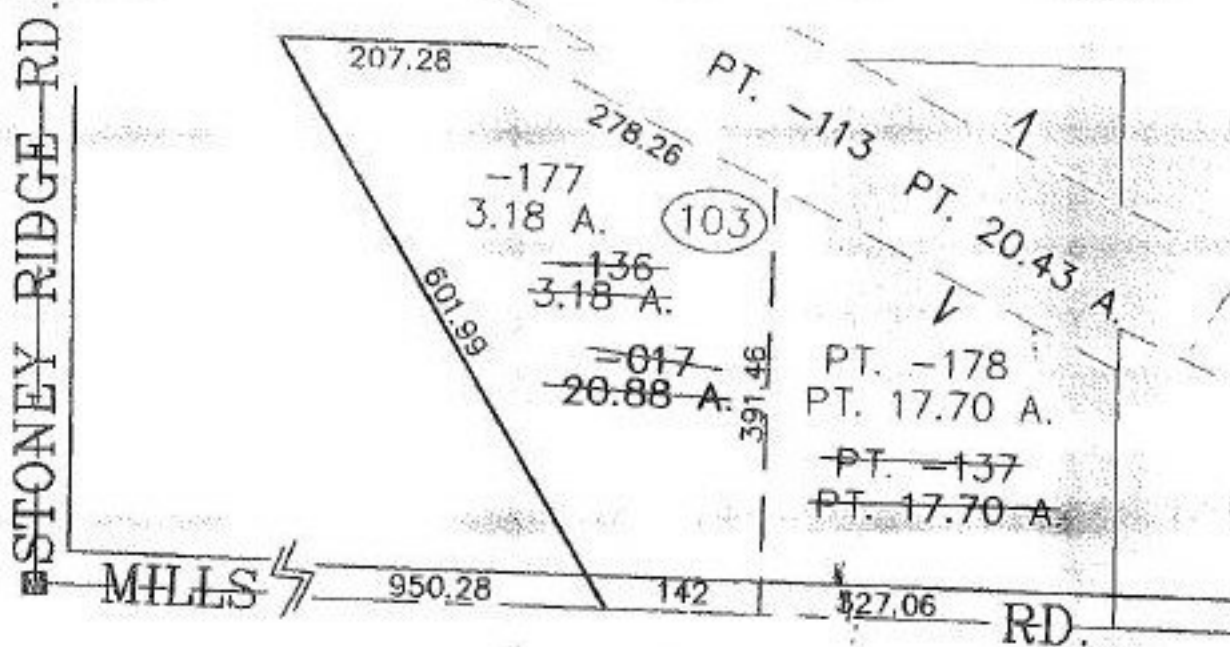

PLATS/DEEDS PROCESSOR
COUNTY CLERK'S OFFICE
COUNTY CLERK'S OFFICE
COUNTY CLERK'S OFFICE

SURVEYED BY: DANE A. HAPONEK
CLOSURE: 0.12 : 10.000
MAP PAGE(S): 4-00-012-C
DRAWN BY: TJS DATE: 10/11/00
SCALE: 1" = 200' PRIOR INSTRUMENT: DV 1136/754