


PARENT PARCEL: 04-00-013-000-385

CHILD PARCEL: 04-00-012-103-179 THRU -181 & 04-00-013-000-387 & -388

STARTING POINT: XXXXXX

NO. 00454-A

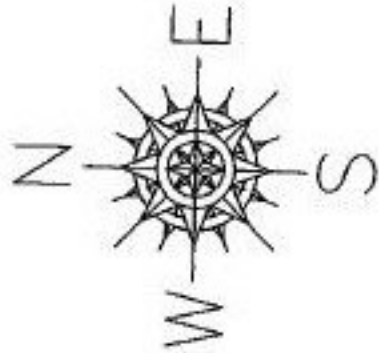

AC. CORR. & UNCOMB.

~~04-00-013-000-385~~

~~17.87 A.~~

~~67.67 A.~~

AC. CORR. PER SURV.
R. THOMPSON JR.

04-00-013-000-387

8.95 A.

04-00-013-000-388

20.27 A.

04-00-012-103-179


15.48 A.

04-00-012-103-180

4.51 A.

04-00-012-103-181

18.45 A.

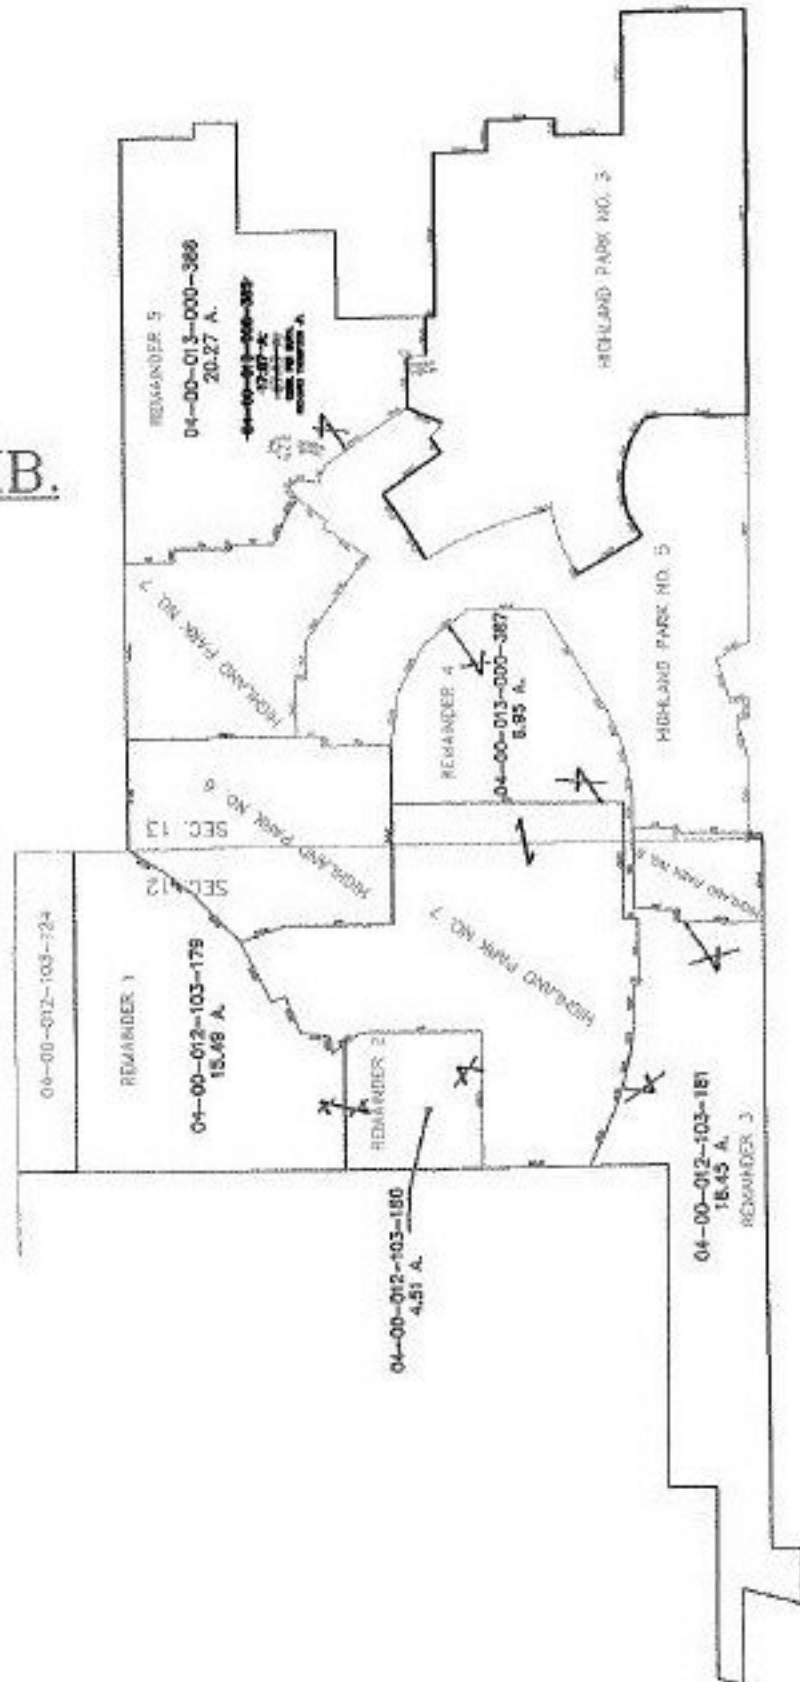

SPLITS/DEEDS PROCESSED

LORAIN COUNTY TAX MAP DEPARTMENT
226 MIDDLE AVE. ELYRIA, OHIO

SURVEYED BY: RICHARD THOMPSON JR.

CLOSURE: 0.02 ; 10.000

MAP PAGE(S): 04-00-012-G & 04-00-013-A & B

APPROVED BY: TJS DATE: 10/12/00

SCALE: 1" = 700' PRIOR INSTRUMENT: NA