


PARENT PARCEL: 03-00-008-000-025

CHILD PARCEL: XX-XX-XXX-XXX-XXX

STARTING POINT: MON. BOX, CL OF ABBE RD. & NORTH LINE OF O.L. 8

NO. 00455-A

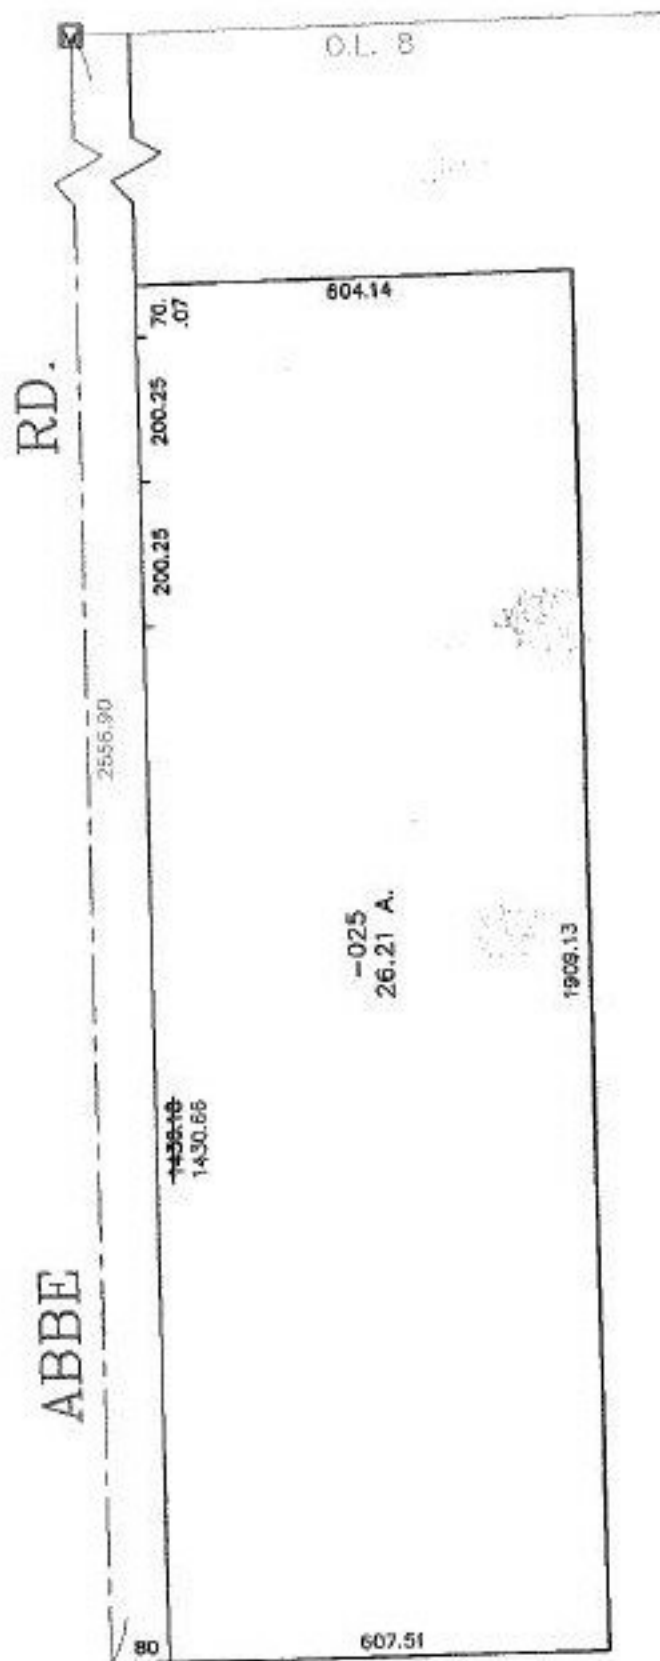

MAP CORRECTION ONLY



SPLITS/DEEDS PROCESSED
LORAIN COUNTY TAX MAP DEPARTMENT
 226 MIDDLE AVE. ELYRIA, OHIO

SURVEYED BY: MICHAEL BRAMHALL

CLOSURE: 0.04 : 10.000

MAP PAGE(S): 3-00-008-A

APPROVED BY: TJS DATE: 11/01/00

SCALE: 1" = 300' PRIOR INSTRUMENT: OR 1208/759