

PARENT PARCEL: 02-02-003-103-018

CHILD PARCEL: XX-XX-XXX-XXX-XXX

STARTING POINT: CL. OF COOPER FOSTER PARK RD. & CL. OF LEAVITT RD.

NO. 00466-C



ACREAGE CORRECTION

02-02-003-103-018

~~0.30~~ A.

0.39 A.

AC. CORR. PER SURV.
J.W. WARDEN

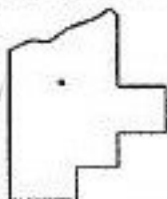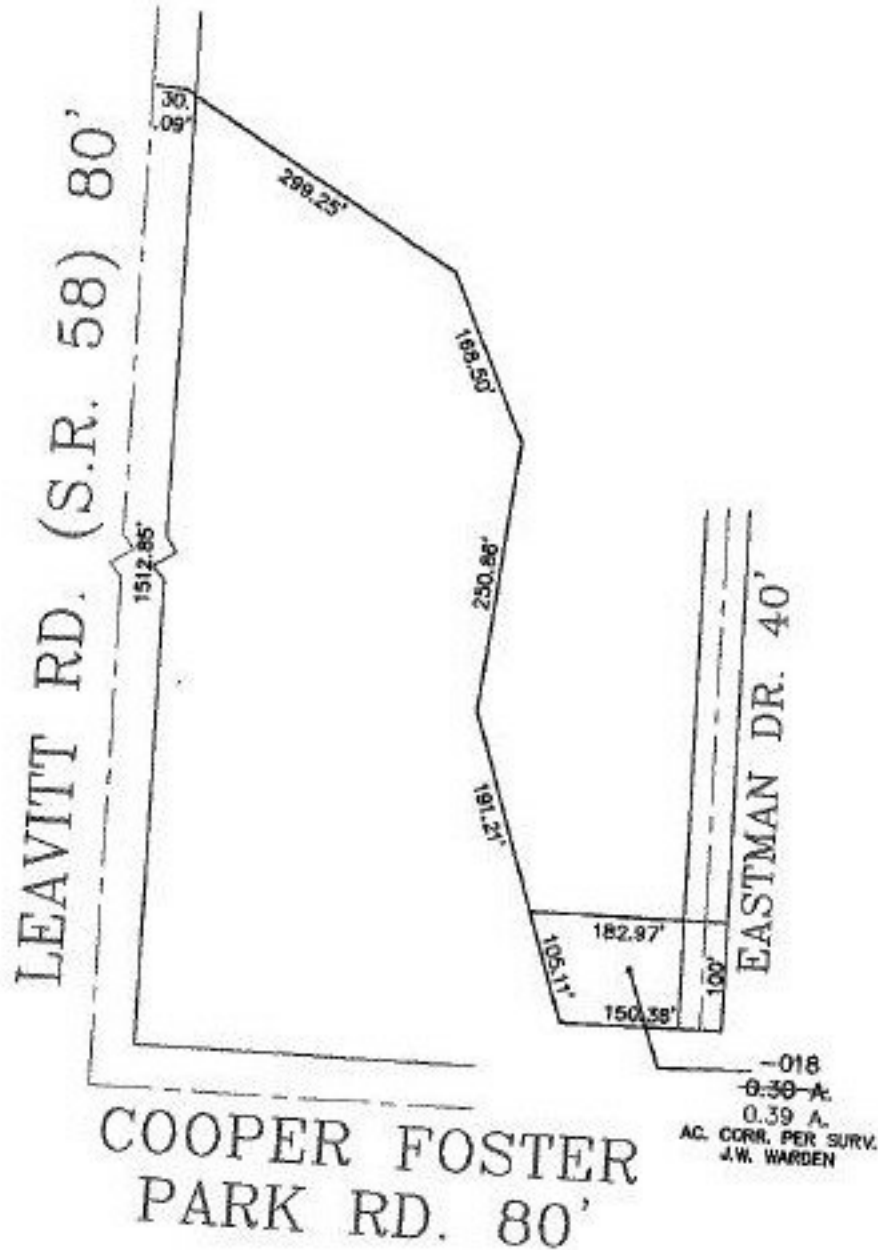

SPLITS/DEEDS PROCESSED
LORAIN COUNTY TAX MAP DEPARTMENT
226 MIDDLE AVE. ELYRIA, OHIO

SURVEYED BY:	J.W. WARDEN
CLOSURE:	4.19 : 10.000
MAP PAGE(S):	02-02-003
APPROVED BY:	TJS DATE: 12/27/00
SCALE:	1" = 200' PRIOR INSTRUMENT: 20000720418