

PARENT PARCEL: 04-00-023-108-080

CHILD PARCEL: XX-XX-XXX-XXX-XXX

STARTING POINT: CL OF JAYCOX RD. & CL OF SCHWARTZ RD.

NO. 00468-A

DEED CHECK


04-00-023-108-080

~~1.27 A.~~

1.28 A.

AC. CORR. PER SURV.

DANE A. HAPONEK

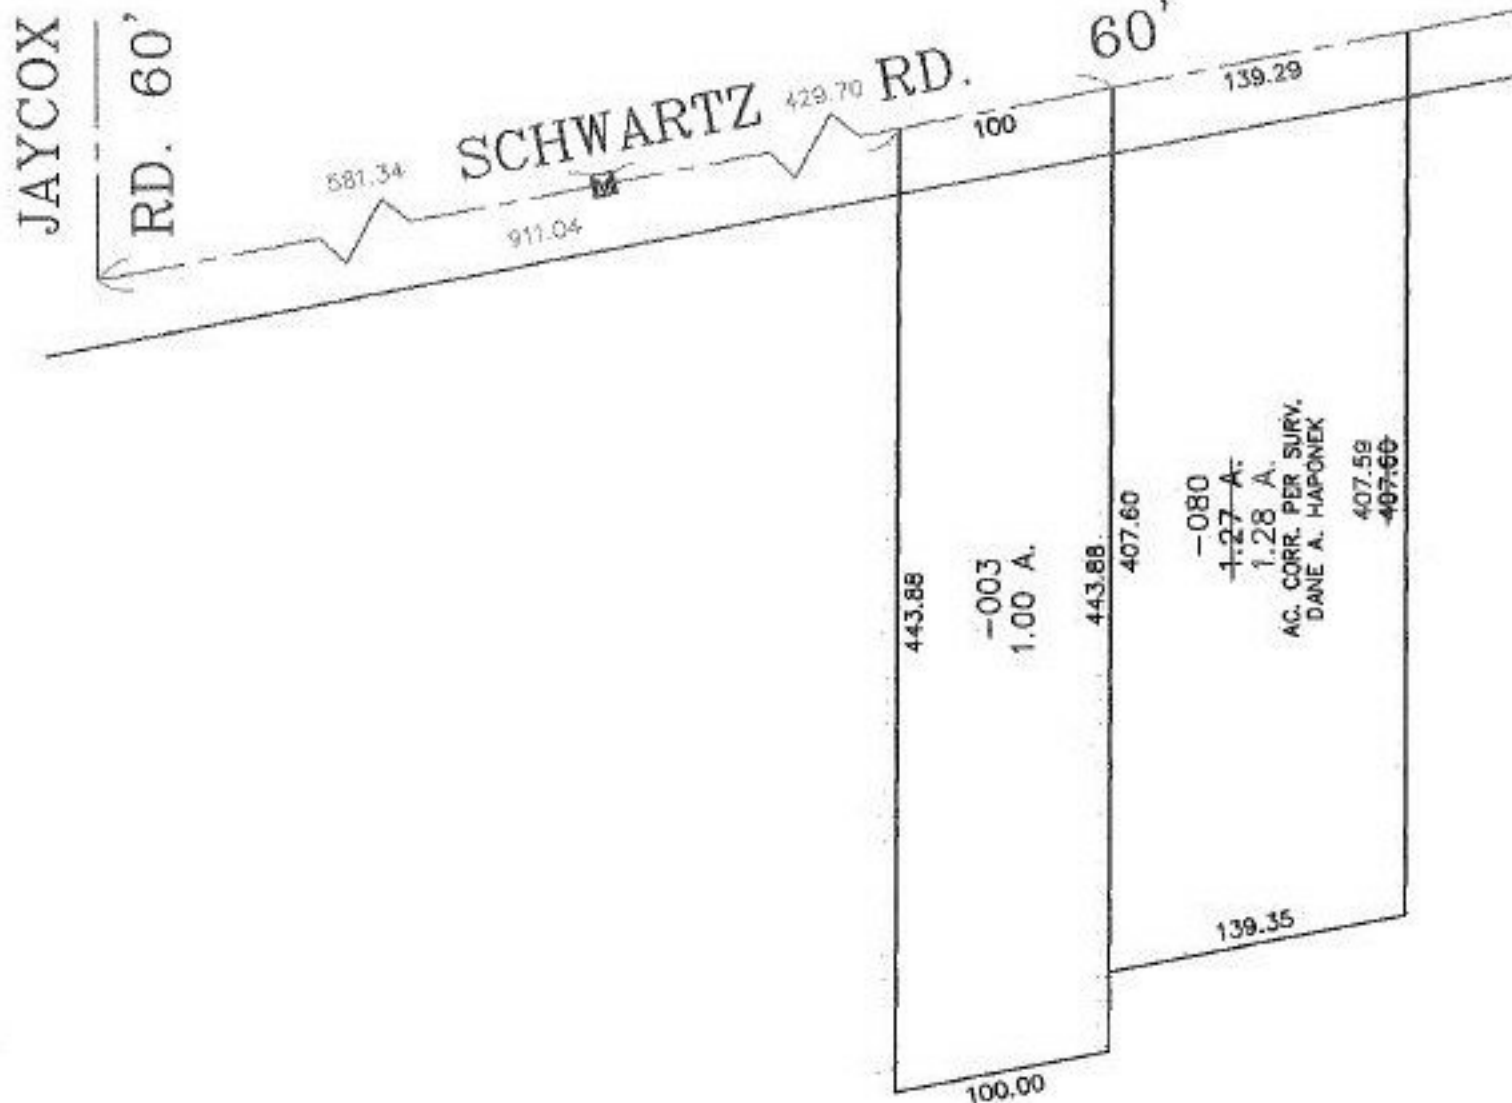

SPLITS/DEEDS PROCESSED

LORAIN COUNTY TAX MAP DEPARTMENT
226 MIDDLE AVE. ELYRIA, OHIO

SURVEYED BY: DANE A. HAPONEK

CLOSURE: 0.01 : 10.000

MAP PAGE(S): 04-00-023-A

APPROVED BY: TJS DATE: 12/11/00

SCALE: 1" = 100' PRIOR INSTRUMENT: 990646801