


PARENT PARCEL: 08-00-103-000-009 , 08-15-004-000-010

CHILD PARCEL: XX-XX-XXX-XXX-XXX

STARTING POINT: MON. BOX , CL. OF BAUMHART RD. & SOUTH LINE OF O.L. 6

NO. 00469-A

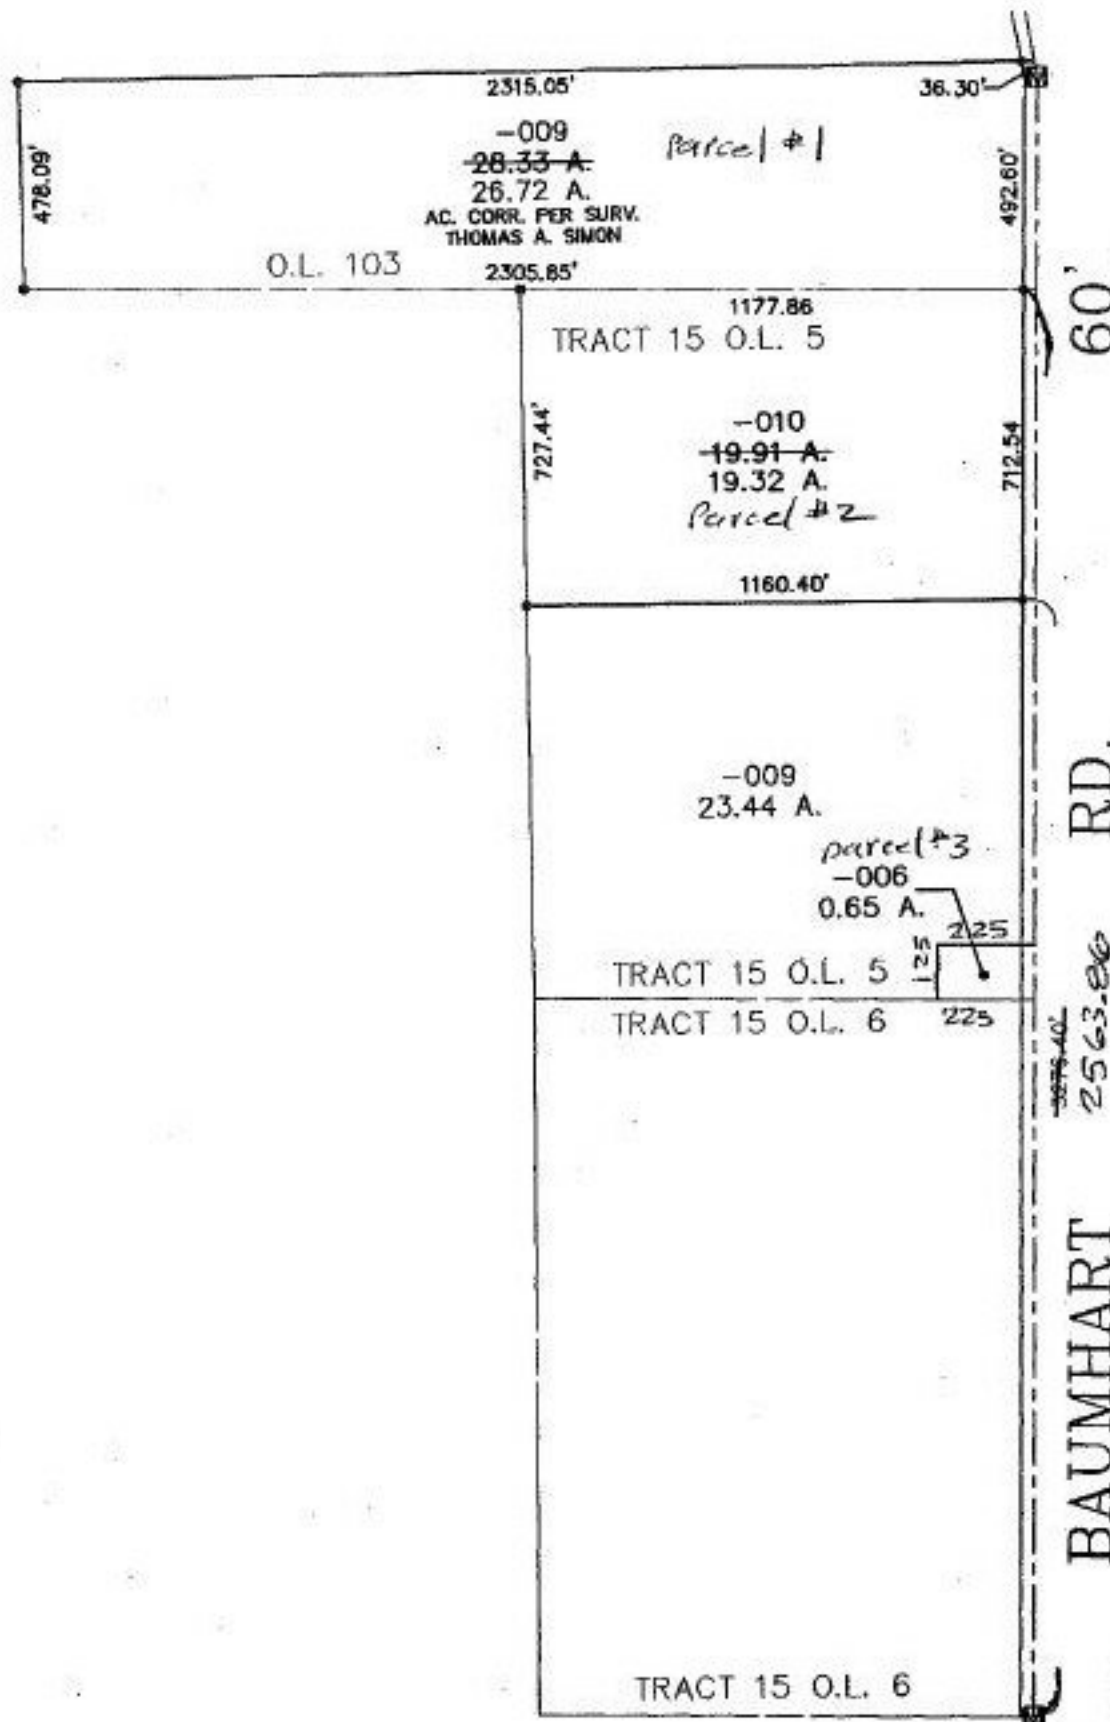

PRIOR INSTRUMENT: DV 986/569  
PRIOR INSTRUMENT: OR 91/461

SPLITS/DEEDS PROCESSED

LORAIN COUNTY TAX MAP DEPARTMENT  
226 MIDDLE AVE. ELYRIA, OHIO

SURVEYED BY: THOMAS A. SIMON

CLOSURE: 0.01 : 10.000

MAP PAGE(S): 8-D

APPROVED BY: TJS DATE: 01/02/01

SCALE: 1" = 500