



PARENT PARCEL: 09-00-053-000-010

CHILD PARCEL: XX-XX-XXX-XXX-XXX

STARTING POINT: MON. BOX, CL OF GARFIELD RD. & N.W. CORNER OF O.L. 53

NO. 00478-A

ACREAGE CORRECTION

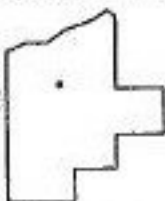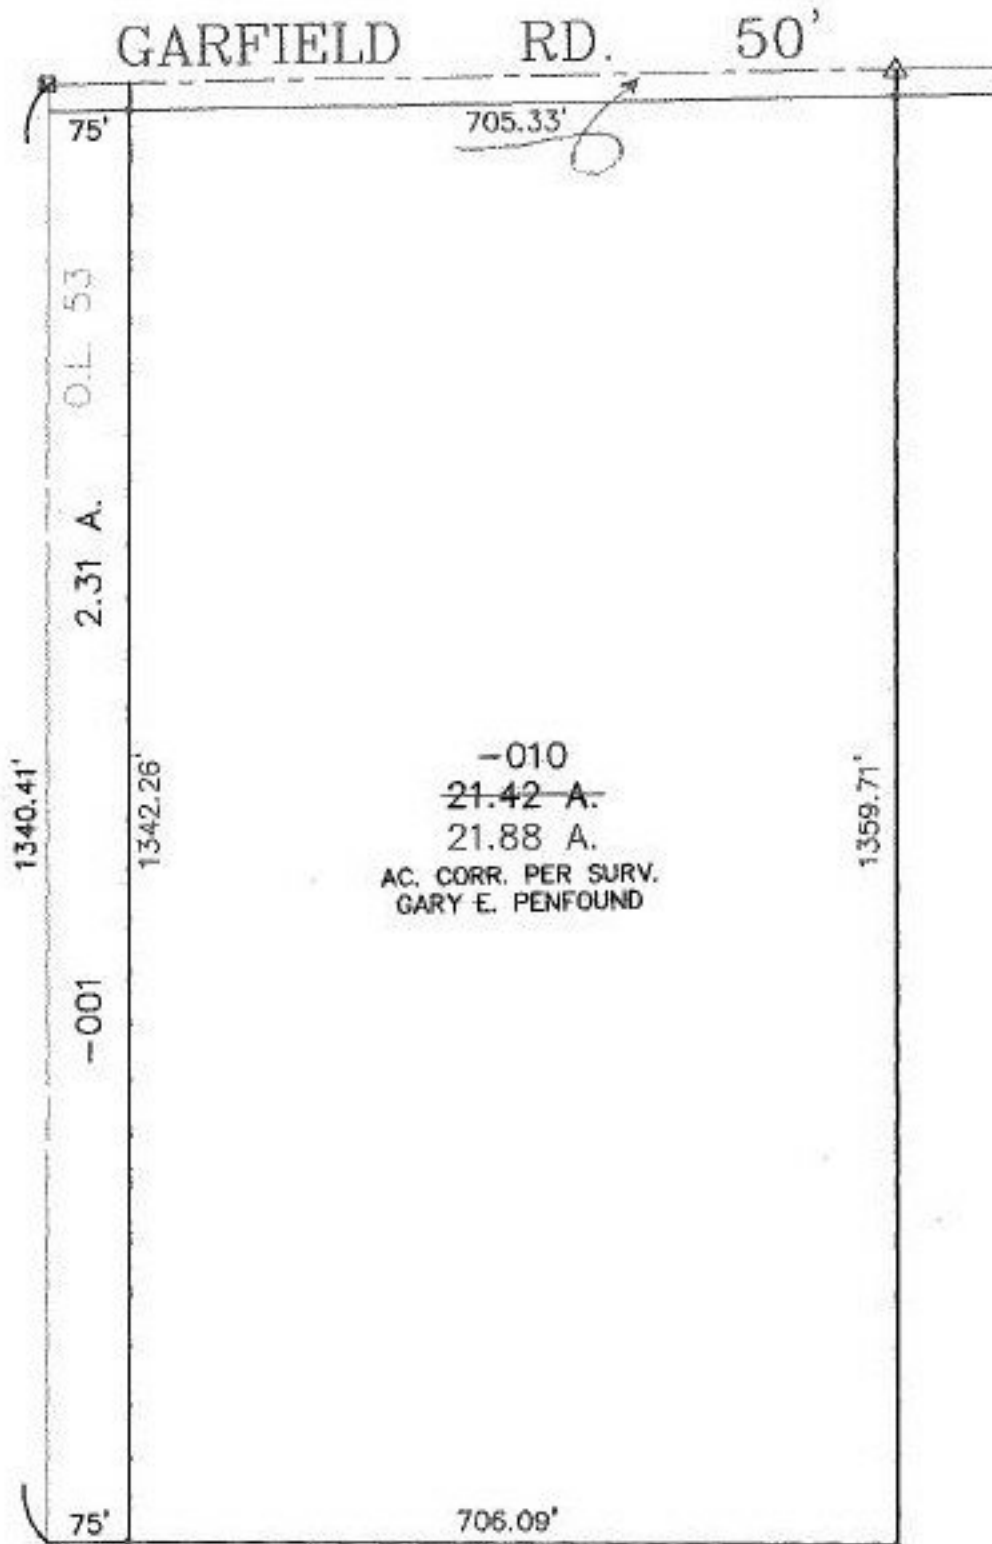

SPLITS/DEEDS PROCESSED
 LORAIN COUNTY TAX MAP DEPARTMENT
 226 MIDDLE AVE. ELYRIA, OHIO

SURVEYED BY: GARY E. PENFOUND
 CLOSURE: 0.27 : 10.000
 MAP PAGE(S): 9-00-009-F
 APPROVED BY: IJS DATE: 12/28/00
 SCALE: 1" = 200' PRIOR INSTRUMENT: DV 1366/652