


PARENT PARCEL: 07-00-014-103-326
 CHILD PARCEL: 07-00-013-000-206
 STARTING POINT: XXXXXX

NO. 00479-C

PARCEL NUMBER & AC. CORRECTION

~~07-00-014-103-326~~
~~0.21 A.~~
~~0.22 A.~~
 07-00-013-000-206
 0.22 A.

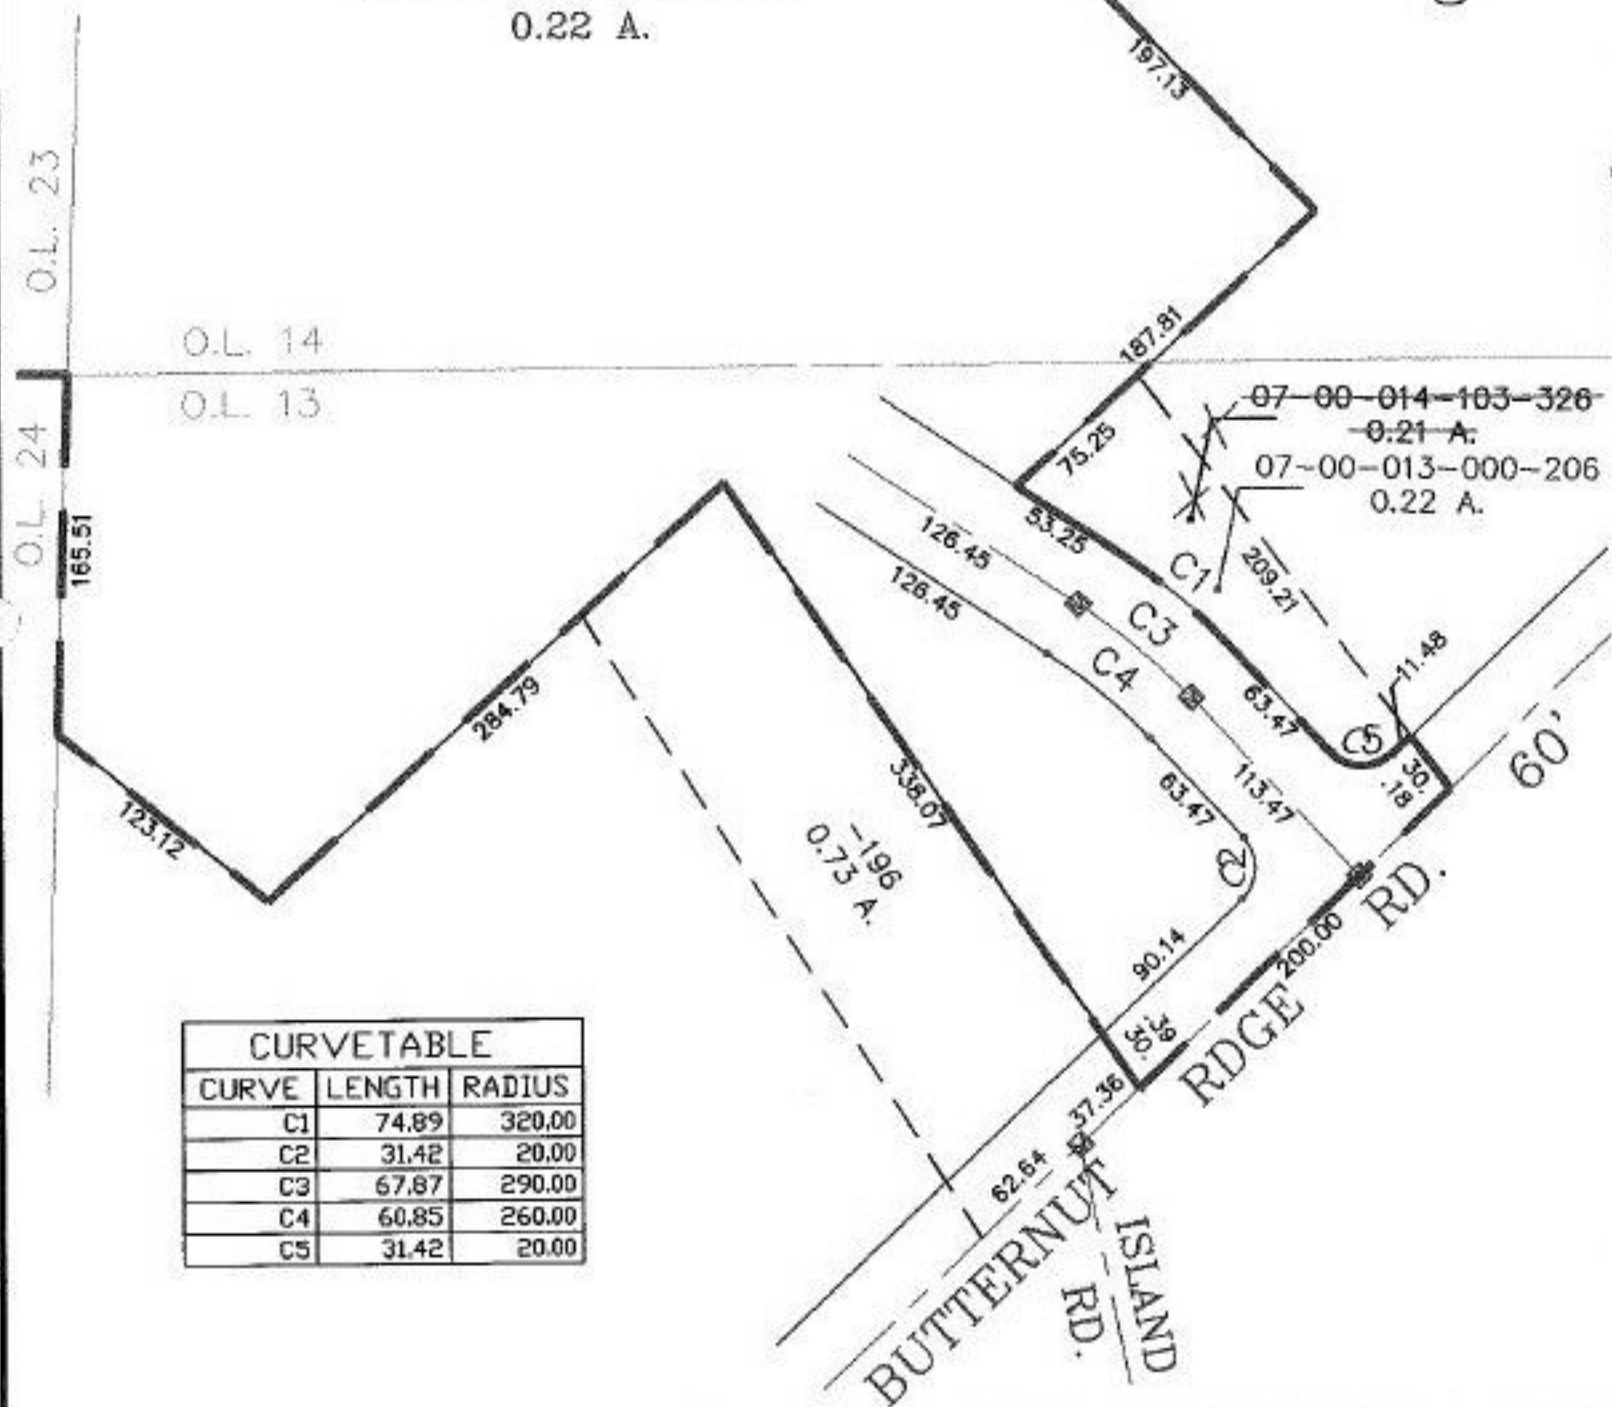

CURVETABLE		
CURVE	LENGTH	RADIUS
C1	74.89	320.00
C2	31.42	20.00
C3	67.87	290.00
C4	60.85	260.00
C5	31.42	20.00



SPLITS/DEEDS PROCESSED
 LORAIN COUNTY TAX MAP DEPARTMENT
 226 MIDDLE AVE. ELYRIA, OHIO

SURVEYED BY: DAVID L. ELWELL
 CLOSURE: 0.01 : 10.000
 MAP PAGE(S): 07-00-013-A
 APPROVED BY: TJS DATE: 11/16/00
 SCALE: 1" = 100' PRIOR INSTRUMENT: PV 66/67-68