


PARENT PARCEL: 05-00-039-105-038, 05-00-040-101-011

CHILD PARCEL:

STARTING POINT: AT THE SOUTHWEST CORNER OF STONEWOOD ESTATES AND
THE EASTERLY ROW LINE OF TERRA LANE


NO. 00489-A

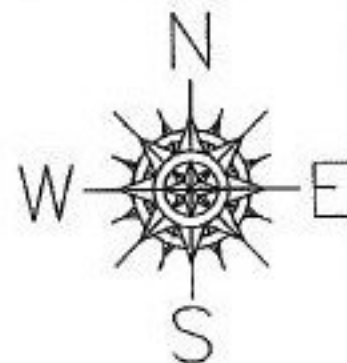

MAP CORRECTION ONLY

STONEWOOD ESTATES

VOL.54 PGS.13-14

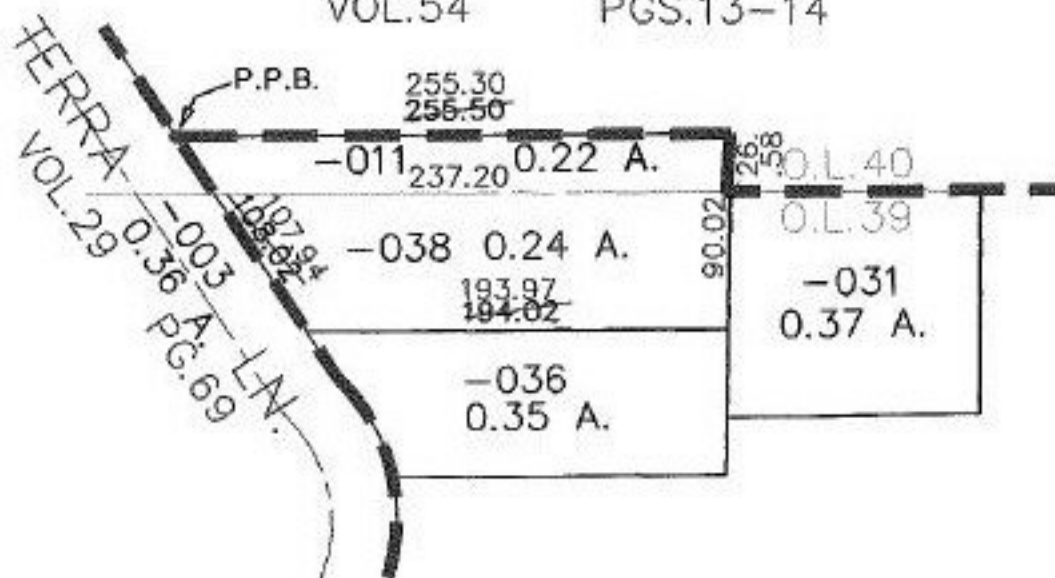

SPLITS/DEEDS PROCESSED

LORAIN COUNTY TAX MAP DEPARTMENT
226 MIDDLE AVE. ELYRIA, OHIO

SURVEYED BY: CHARLES P. WARYU

CLOSURE: 38:10.000

MAP PAGE(S): 05-00-039-A, 05-00-040-A

APPROVED BY: RRM DATE: 1-17-01

SCALE: 1" = 100' PRIOR INSTRUMENT: OR 1220/395