

PARENT PARCEL: 02-02-001-104-075


CHILD PARCEL:

STARTING POINT: IRON PIPE FOUND ON THE SOUTHWEST CORNER OF SUBLT NO. 1 OF COBANT SUBD.

NO. 00495-A



COBANT SUBD.
VOL.14 PG.14A

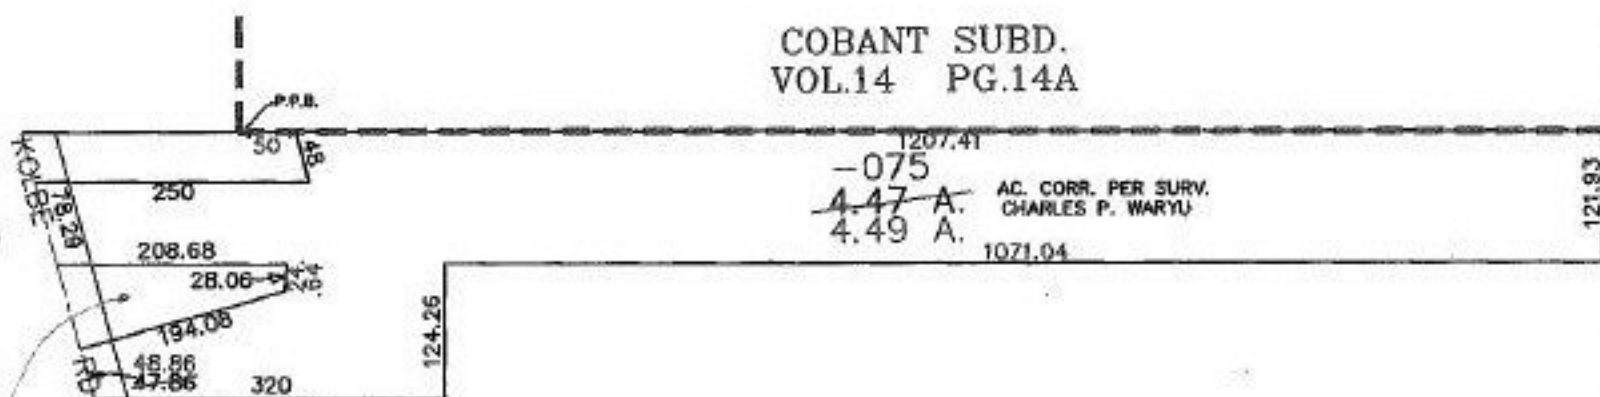

AC. CORR. PER SURV.
CHARLES P. WARYU

980516382 date 2/10/98
P & P Partnership



SPLITS/DEEDS PROCESSED
LORAIN COUNTY TAX MAP DEPARTMENT
226 MIDDLE AVE. ELYRIA, OHIO

SURVEYED BY: CHARLES P. WARYU
CLOSURE: 24:10.000
MAP PAGE(S): 02-02-001-A
APPROVED BY: BRM DATE: 12/27/00
SCALE: 1" = 200' PRIOR INSTRUMENT: 990516382