


- 002 52.86 A.

REF. 20000711 954

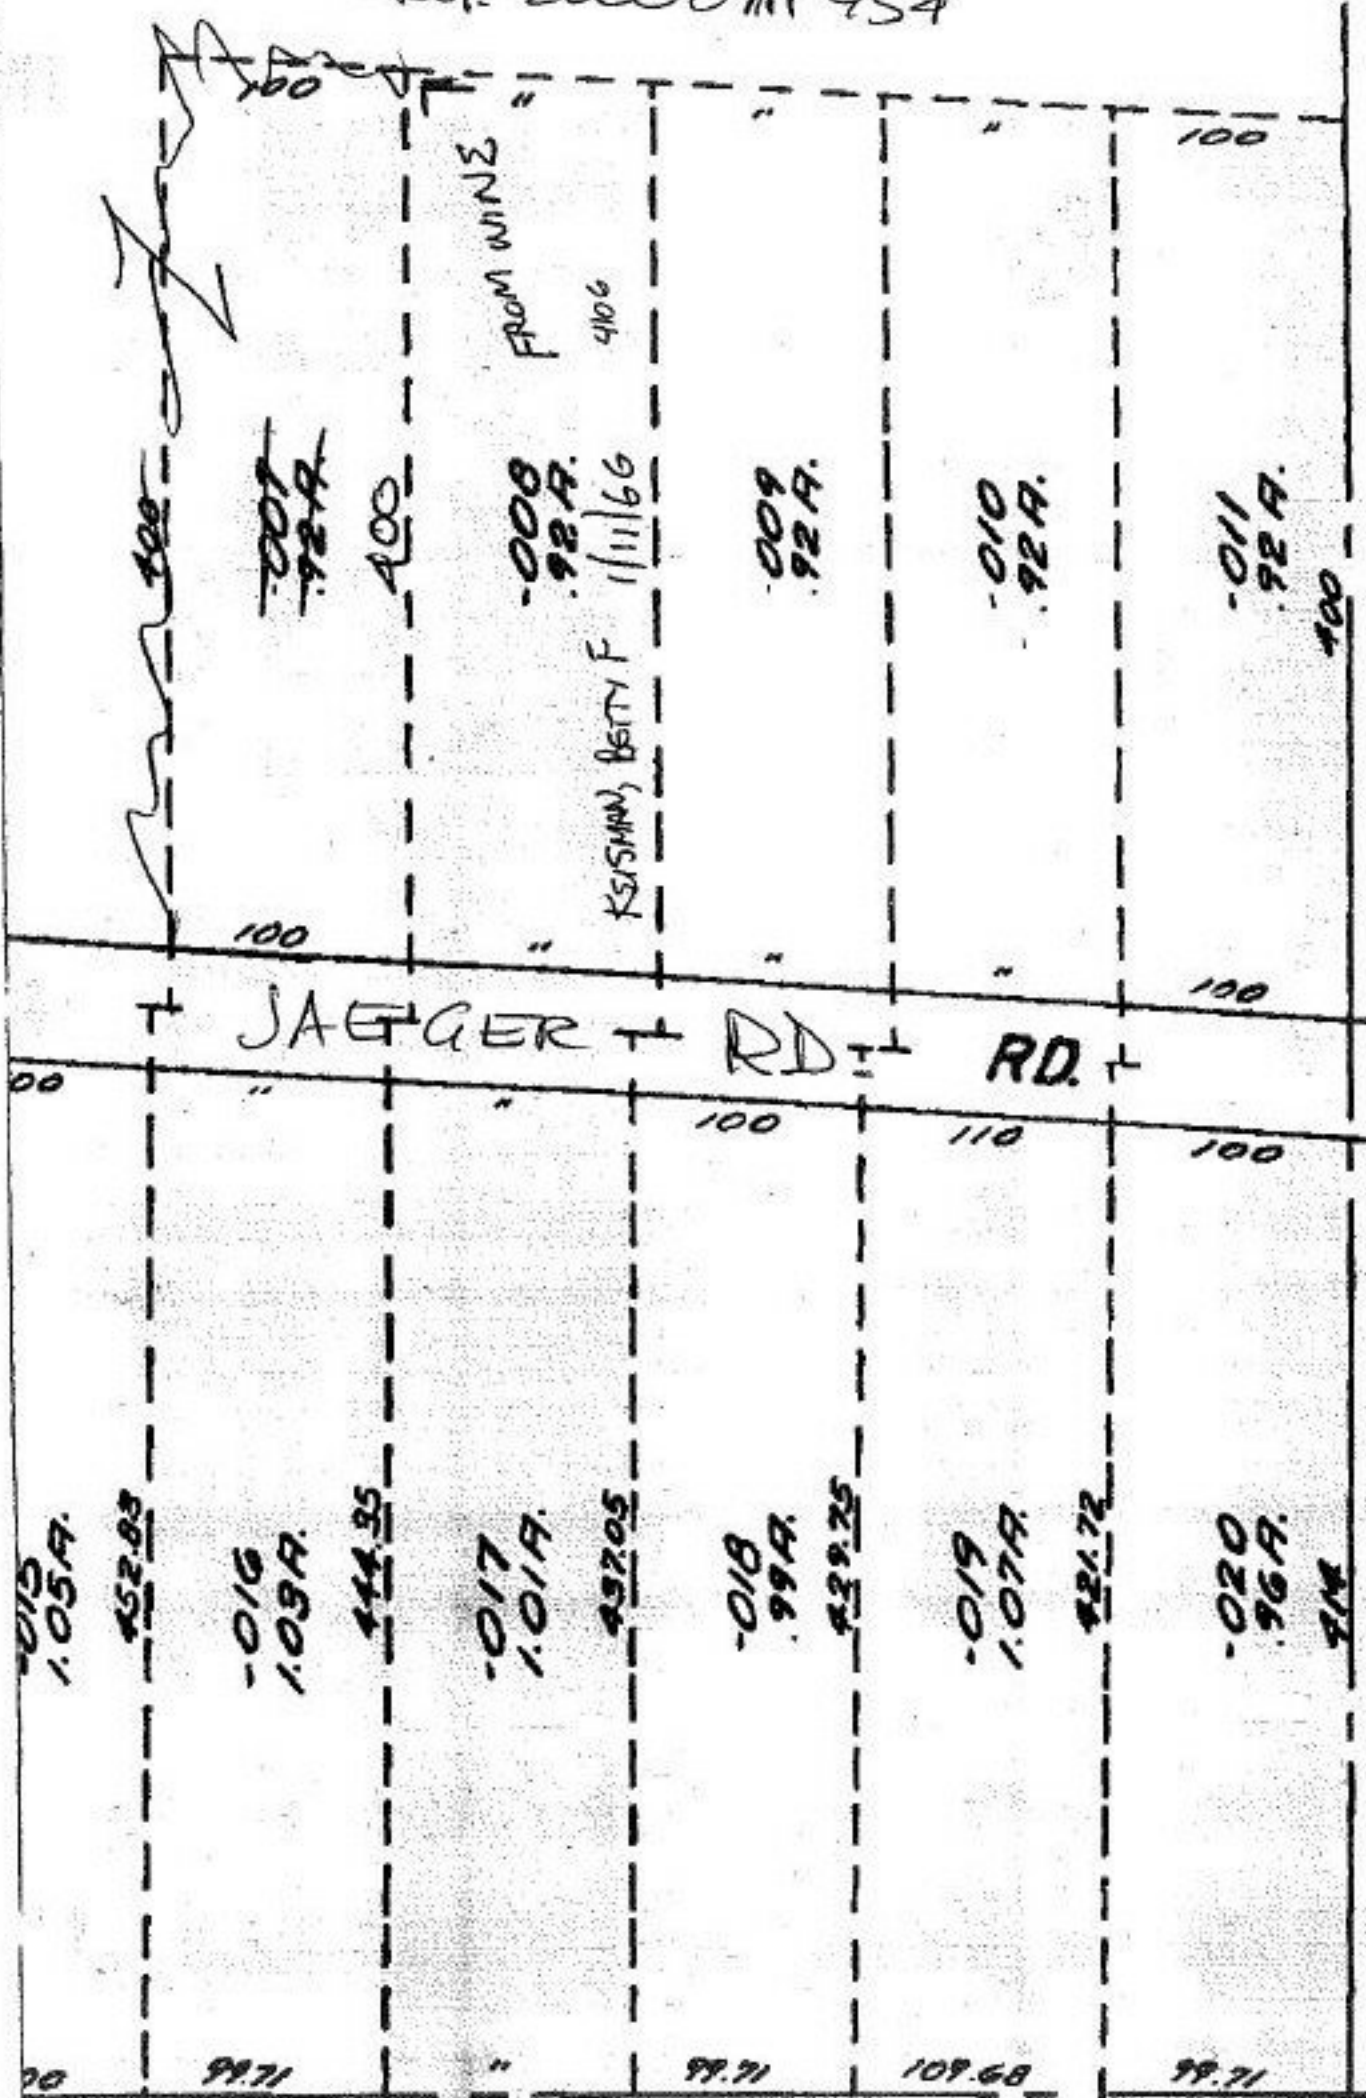

012
 #00500-D
 015
 MOON ORVILLE
 FARMY JR + S

APPROVED LORAIN CO. MAP DEPT
DATE -24.01
PAGE 2-02-010-B
BY T. McHain
MEAL