


SEE 2-02-010-A

Doc 20

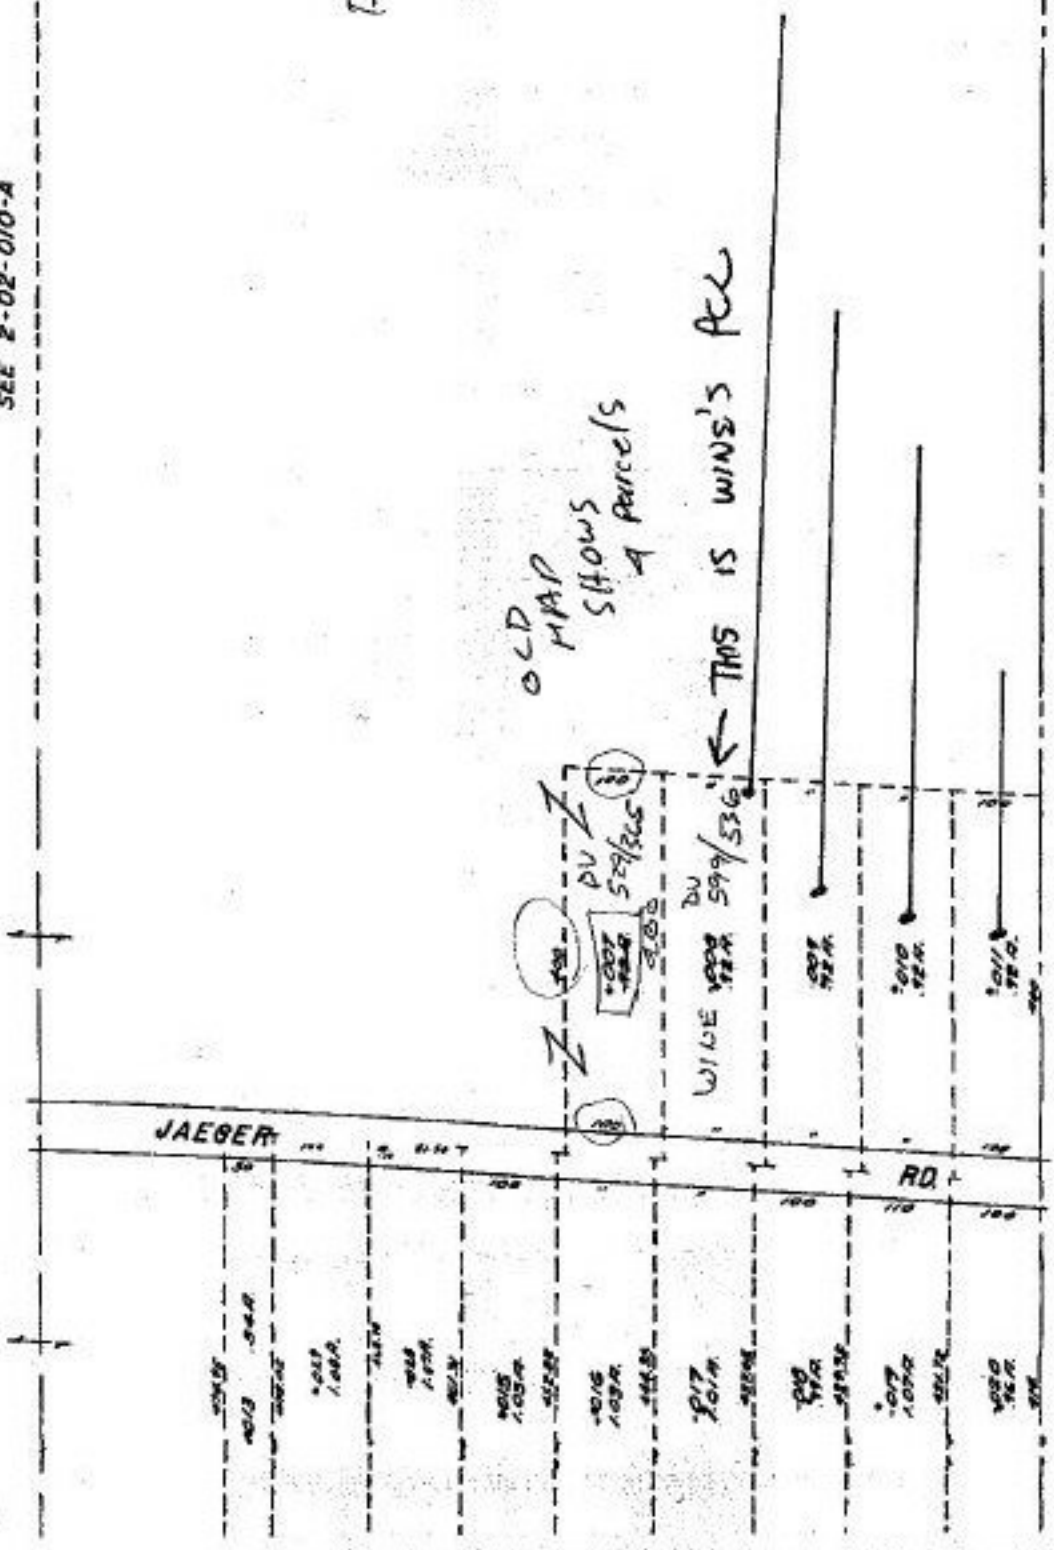

SEE 2-02-009-A

00-00500-D

DROP FROM DUPLICATE

APPROVED LORAIN CO. MAP. DEPT
DATE 1-18-01
PAGE 2-02-010-B
BY T. McMain 00500-D