

SEE 2-02-010-A


also

SEE DV 769/623

PCC 20

DV 508/206

SEE 2-02-010-A

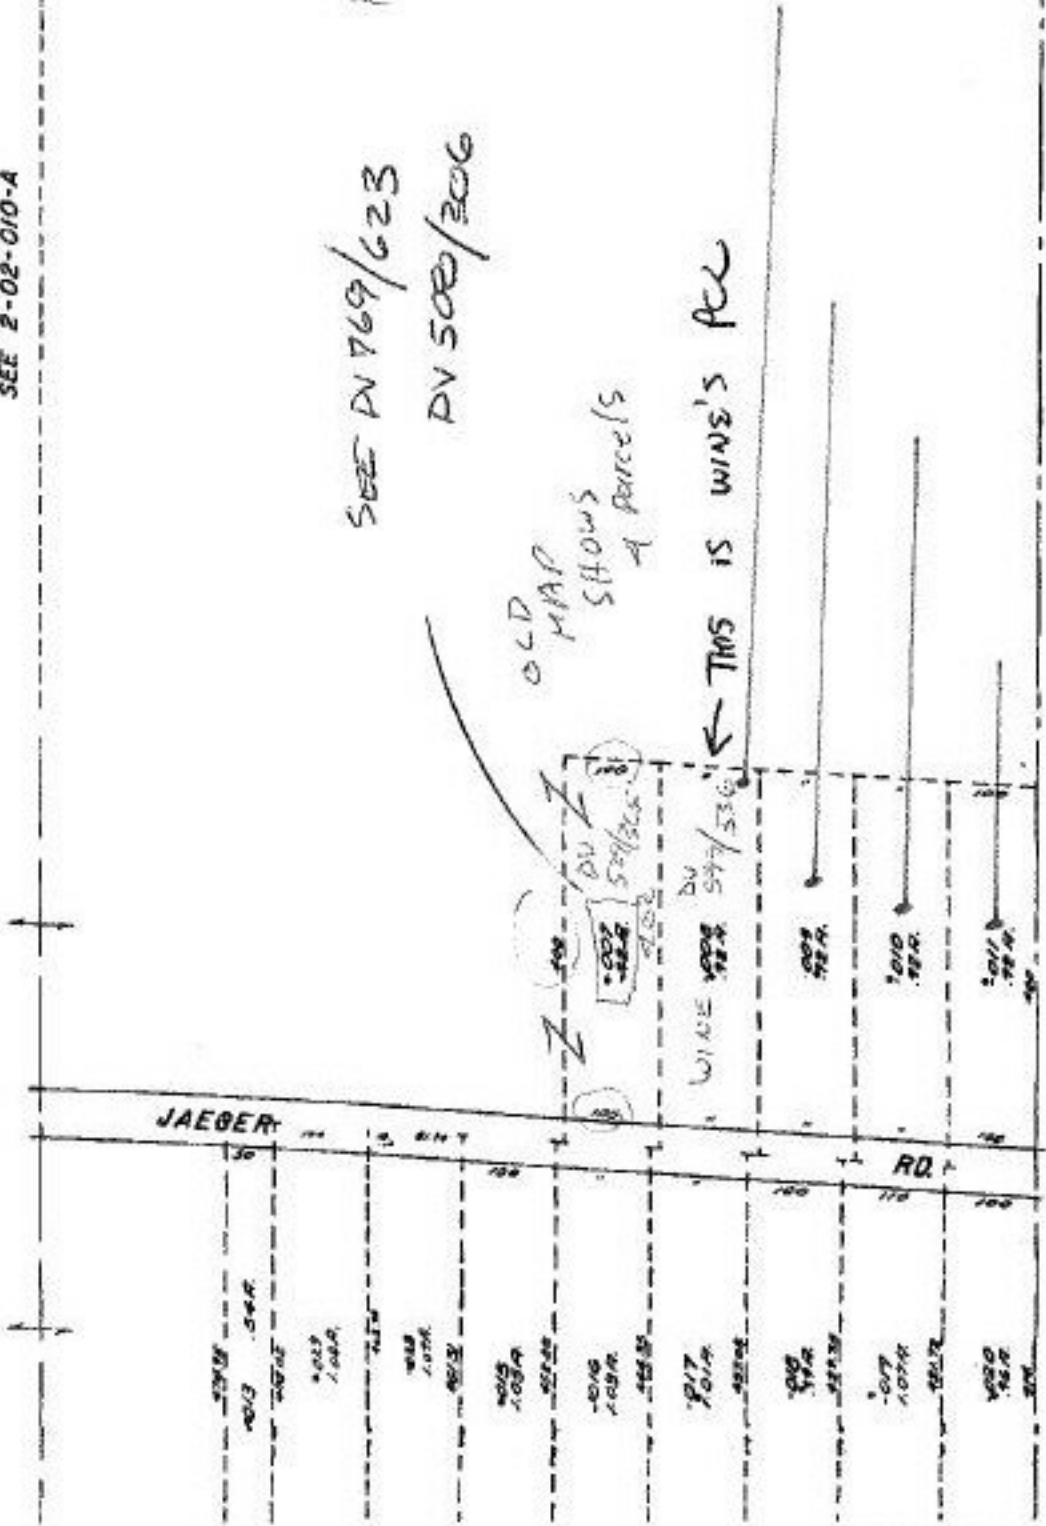

SEE 2-02-009-A

00-00500-D

DROP FROM DUPLICATE

APPROVED LORAIN CO. MAP DEPT
DATE 1-18-01
PAGE 2-02-010-B
BY T. McNeil 00500-D