


RASTER


PARENT PARCEL: 07-00-014-103-259,-260  
CHILD PARCEL:  
STARTING POINT: PART OF DEERFIELD MEADOWS SUBD. NO.2

NO. 00503-A

CERTIFICATE OF CORR.  
FOR PLAT  
MAP CORR. ONLY

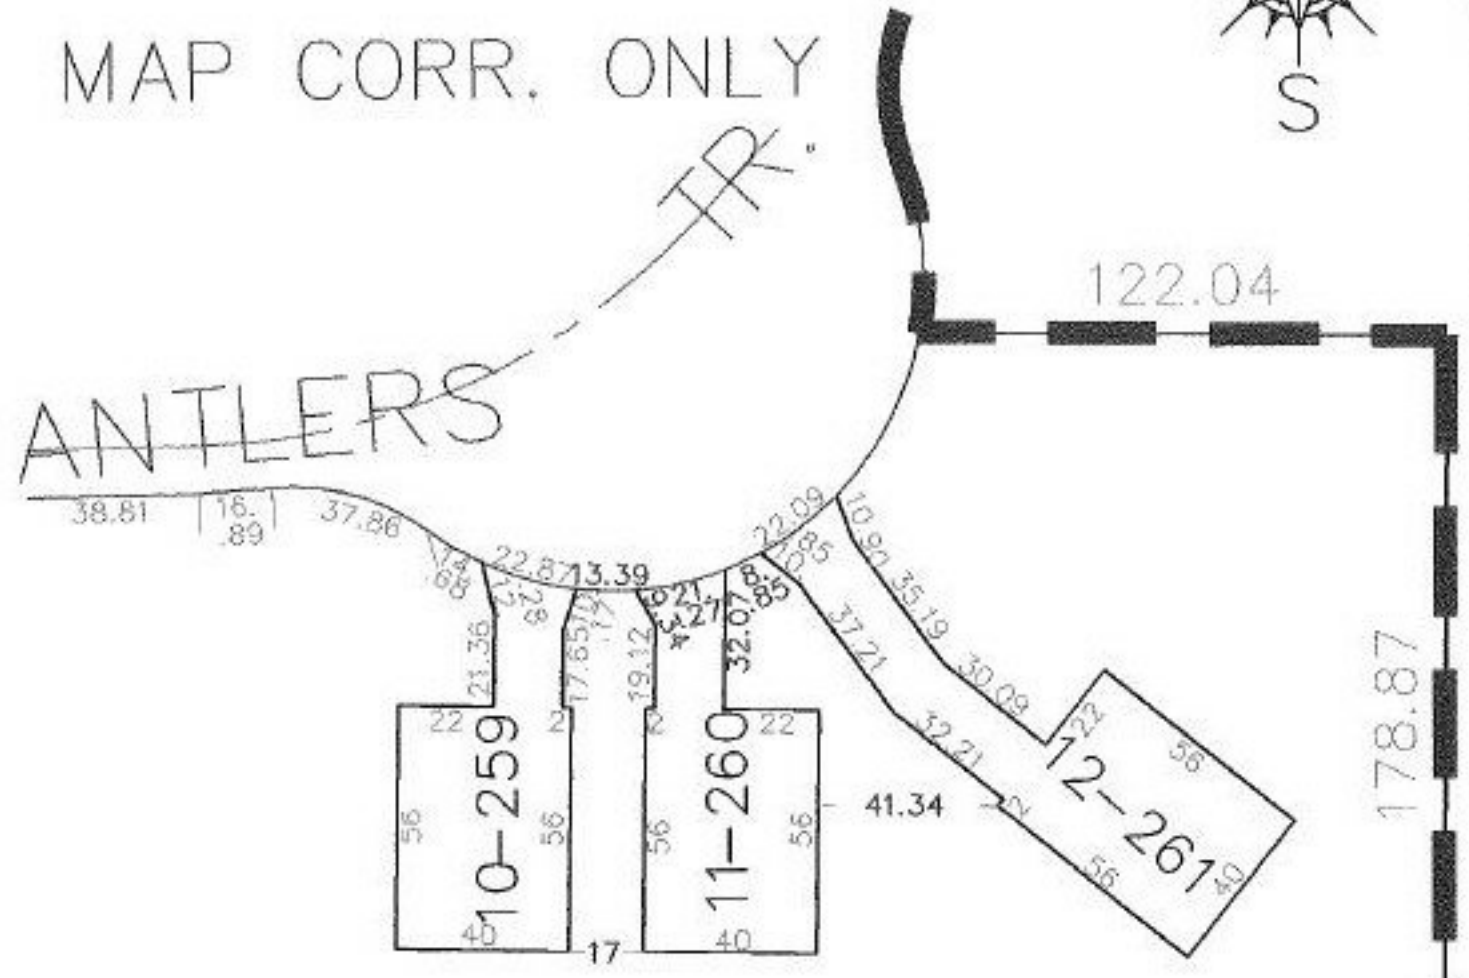

DEERFIELD MEADOWS  
PHASE NO. 2  
VOL.65 PGS.31-32

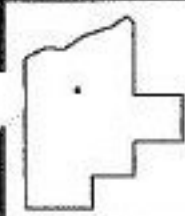

**SPLITS/DEEDS PROCESSED**  
LORAIN COUNTY TAX MAP DEPARTMENT  
226 MIDDLE AVE. ELYRIA, OHIO

SURVEYED BY: DANE A. HAPONEK  
CLOSURE: N/A  
MAP PAGE(S): 7-00-014-C  
APPROVED BY: RRM DATE: 1-24-01  
SCALE: 1" = 50' PRIOR INSTRUMENT: N/A