


PARENT PARCEL: 02-01-003-214-001, THRU -004

CHILD PARCEL: XXXXXXXXXXXX *N.A.*

STARTING POINT: XXXXXXXXXXXX *N.A.*

NO. 00082-X

DEPTH CORRECTION

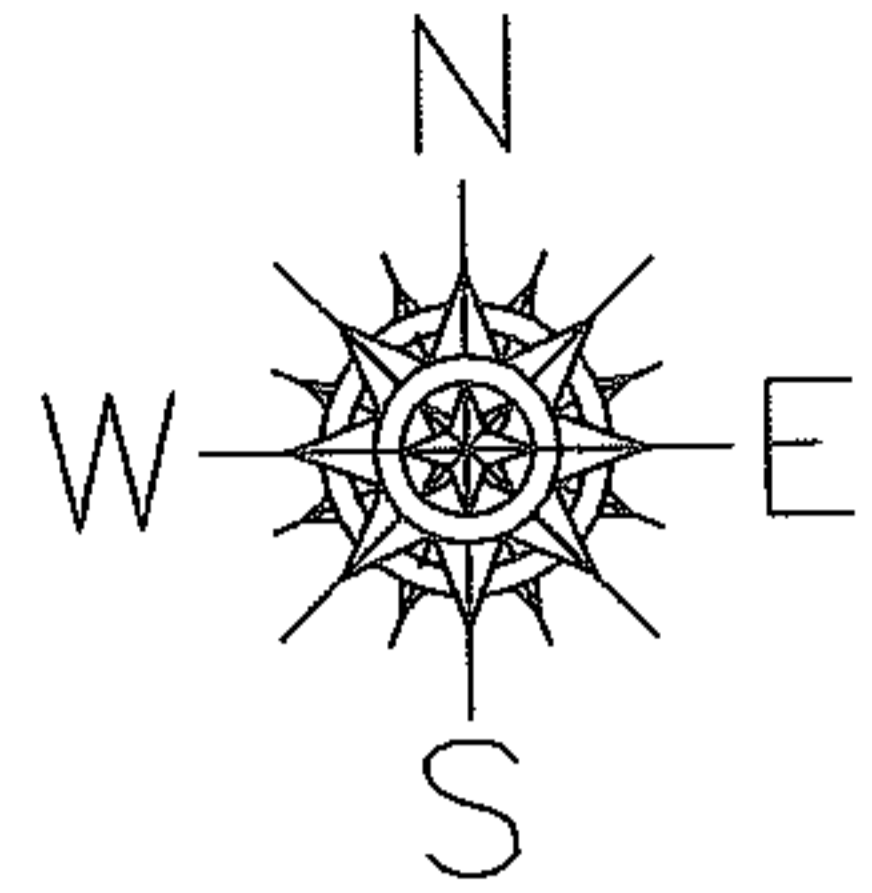

02-01-003-214-001

~~55 X 150~~

55 X 143

02-01-003-214-002

~~50 X 150~~

50 X 143

02-01-003-214-003

~~50 X 150~~


50 X 143

02-01-003-214-004

~~50 X 150~~

50 X 143

*NO MAP
PER DEED
FEE*

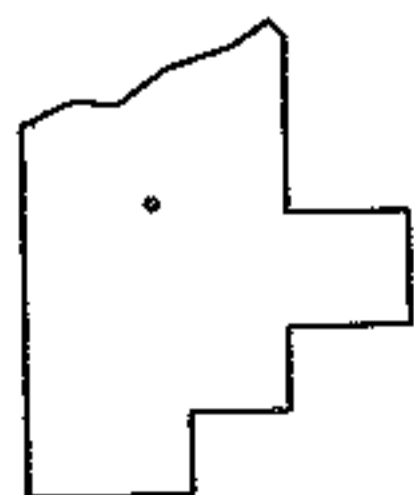

SPLITS/DEEDS PROCESSED
LORAIN COUNTY TAX MAP DEPARTMENT
226 MIDDLE AVE. ELYRIA, OHIO

SURVEYED BY: NONE
CLOSURE: NA
MAP PAGE(S): 02-01-003-J
APPROVED BY: TJS DATE: 06/23/99
SCALE: 1" = 50' PRIOR INSTRUMENT: NONE