
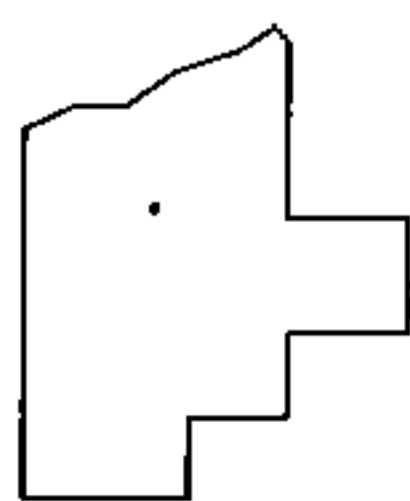
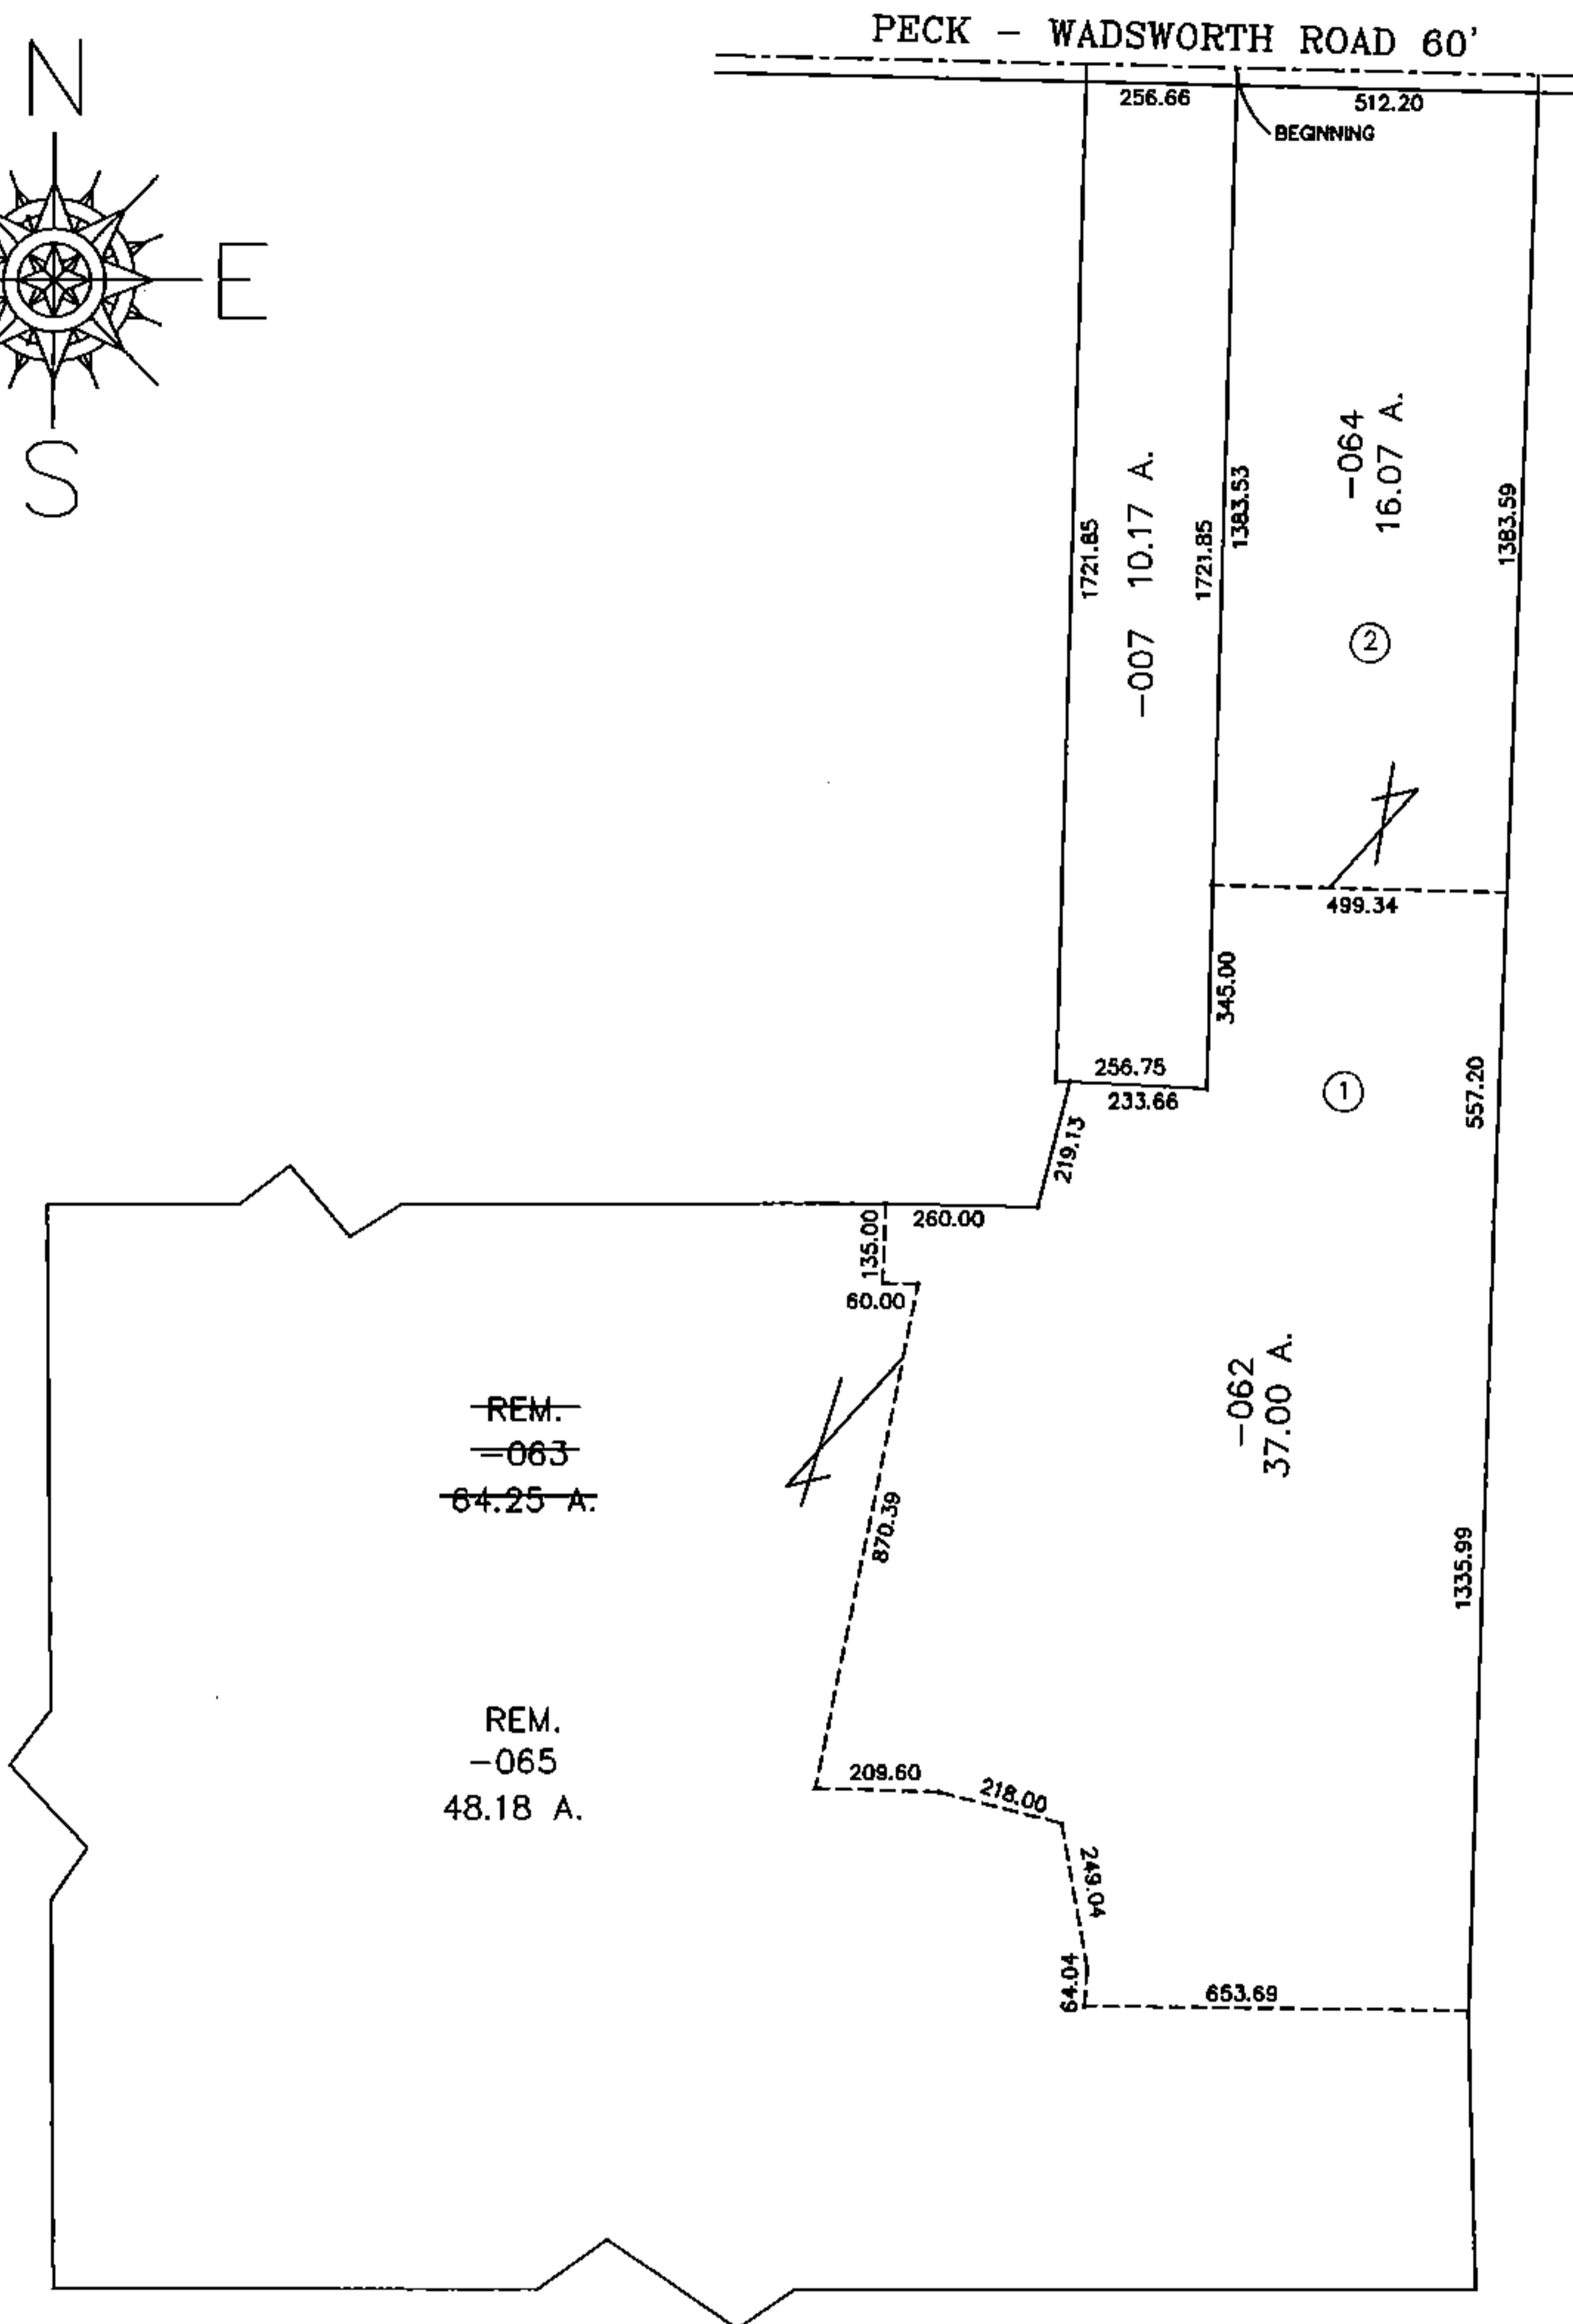


PARENT PARCEL: 18-00-044-000-006 & -009

CHILD PARCEL: 18-00-044-000-062 THRU -065

STARTING POINT: C.L. OF PECK-WADSWORTH RD. & N.E. CORNER OF AURTHUR & NORMA SULLIVAN

99-00095

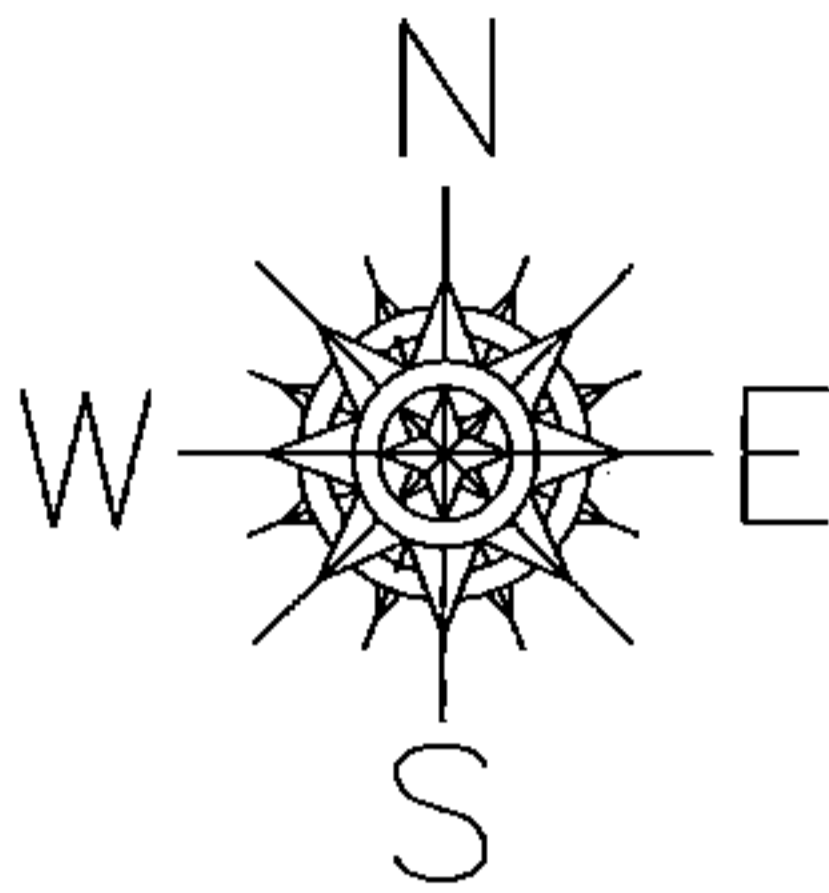

SPLITS/DEEDS PROCESSED
 LORAIN COUNTY TAX MAP DEPARTMENT
 226 MIDDLE AVE. ELYRIA, OHIO

SURVEYED BY: DAVID L. ELWELL
 CLOSURE: 0.01 : 10.000
 MAP PAGE(S): 18-00-044-B & D
 APPROVED BY: DRH DATE: 5/7/99
 SCALE: 1" = 500 PRIOR INSTRUMENT: DV 846/666