

PARENT PARCEL: 09-00-107-000-005


CHILD PARCEL: 09-00-107-000-013 & -014

STARTING POINT: CL OF HAMILTON RD. & N.W. CORNER OF O.L. 107

NO. 00103



HAMILTON RD. 60'

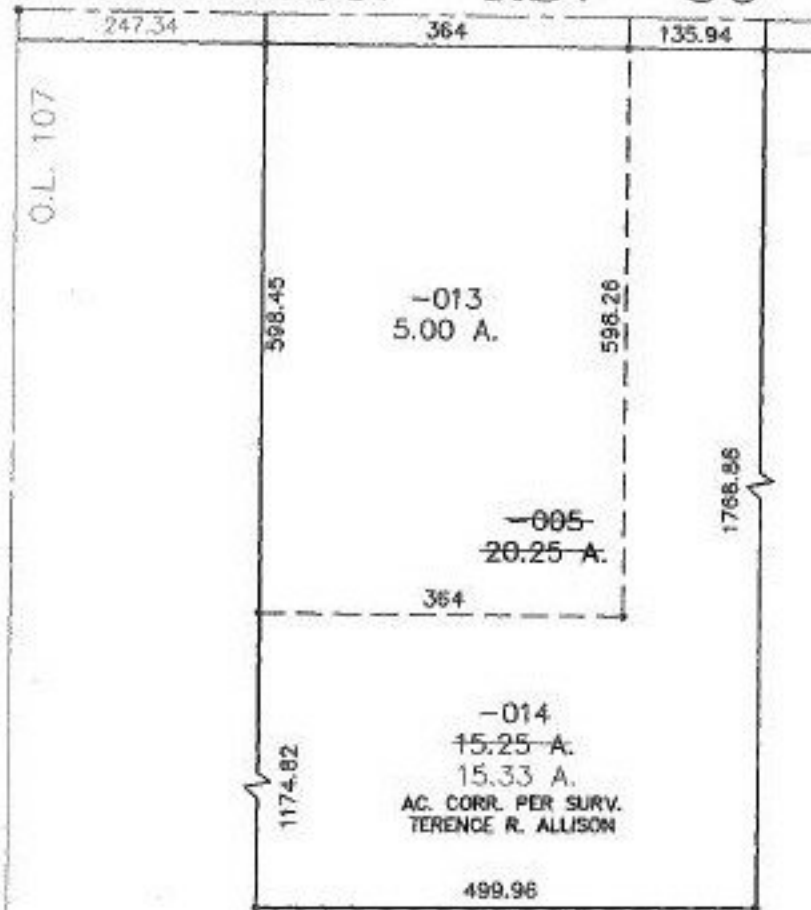

TS
2-14-00



SPLITS/DEEDS PROCESSED
LORAIN COUNTY TAX MAP DEPARTMENT
226 MIDDLE AVE. ELYRIA, OHIO

SURVEYED BY: TERENCE R. ALLISON
CLOSURE: 0.01 : 10,000
MAP PAGE(S): 9-G
APPROVED BY: TJS DATE: 05/27/99
SCALE: 1" = 200' PRIOR INSTRUMENT: OR 1396/386