

PARENT PARCEL: 03-00-036-124-019


CHILD PARCEL: XXXXXXXXXXXX

STARTING POINT: S/L 61 IN SHORE SUB. & BUCKEYE COUNTRY CLUB

NO. 00104-X



~~RICHIEU AVE. 50'~~

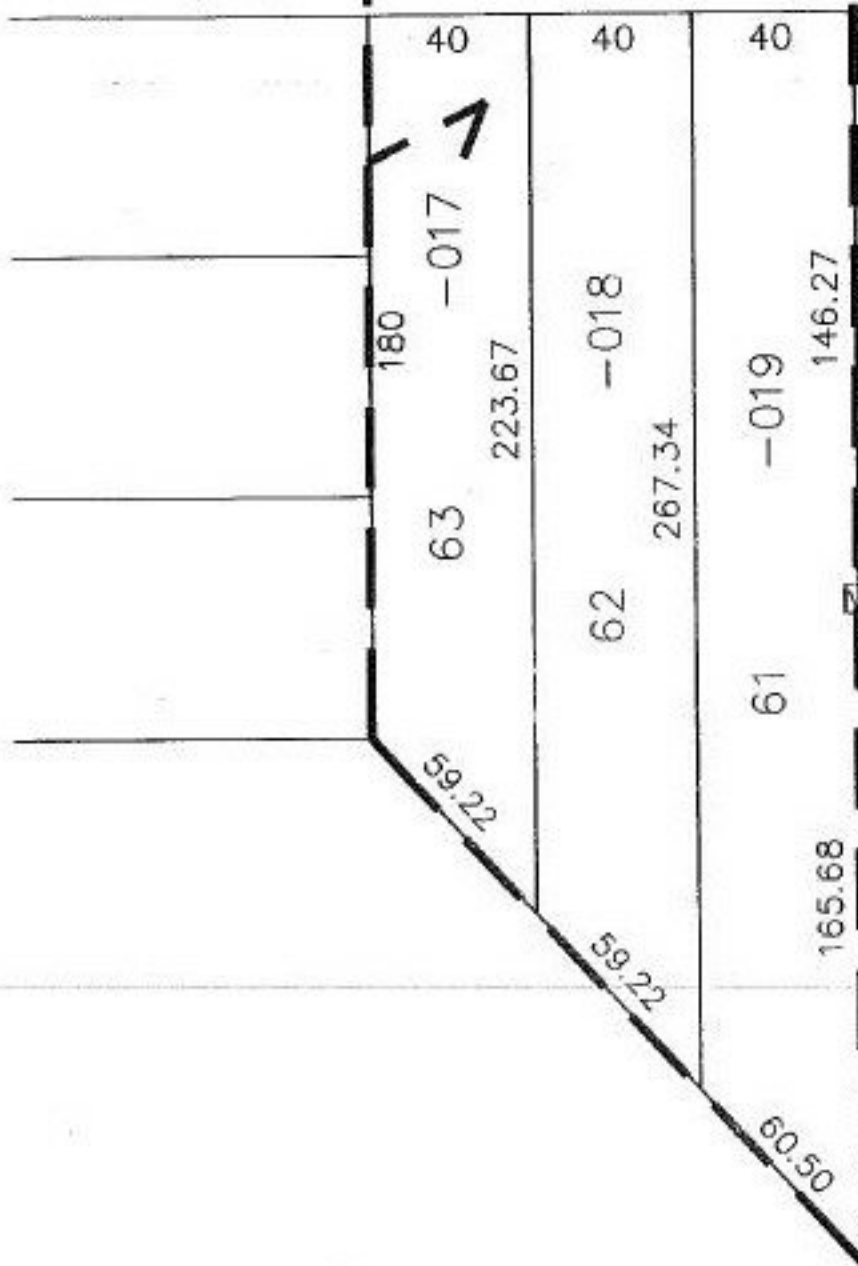

DEPTH CORR.

03-00-036-124-019

~~40 X 267~~

40 X 311.95

STONE
MON.

CORR. PER PLAT
V. 11 PG. 13 & 14



SPLITS/DEEDS PROCESSED
LORAIN COUNTY TAX MAP DEPARTMENT
226 MIDDLE AVE. ELYRIA, OHIO

SURVEYED BY: PLAT VOL. 11/13 & 14

CLOSURE: NA

MAP PAGE(S): 03-00-036-B

APPROVED BY: I. SPILLMAN DATE: 07/23/99

SCALE: 1" = 50' PRIOR INSTRUMENT: NA