


PARENT PARCEL: 01-00-011-000-012

CHILD PARCEL: XX-XX-XXX-XXX-XXX

STARTING POINT: CL. OF BAUMHART RD. & CL. OF BROWNHELM STATION RD.

NO. 00113-A

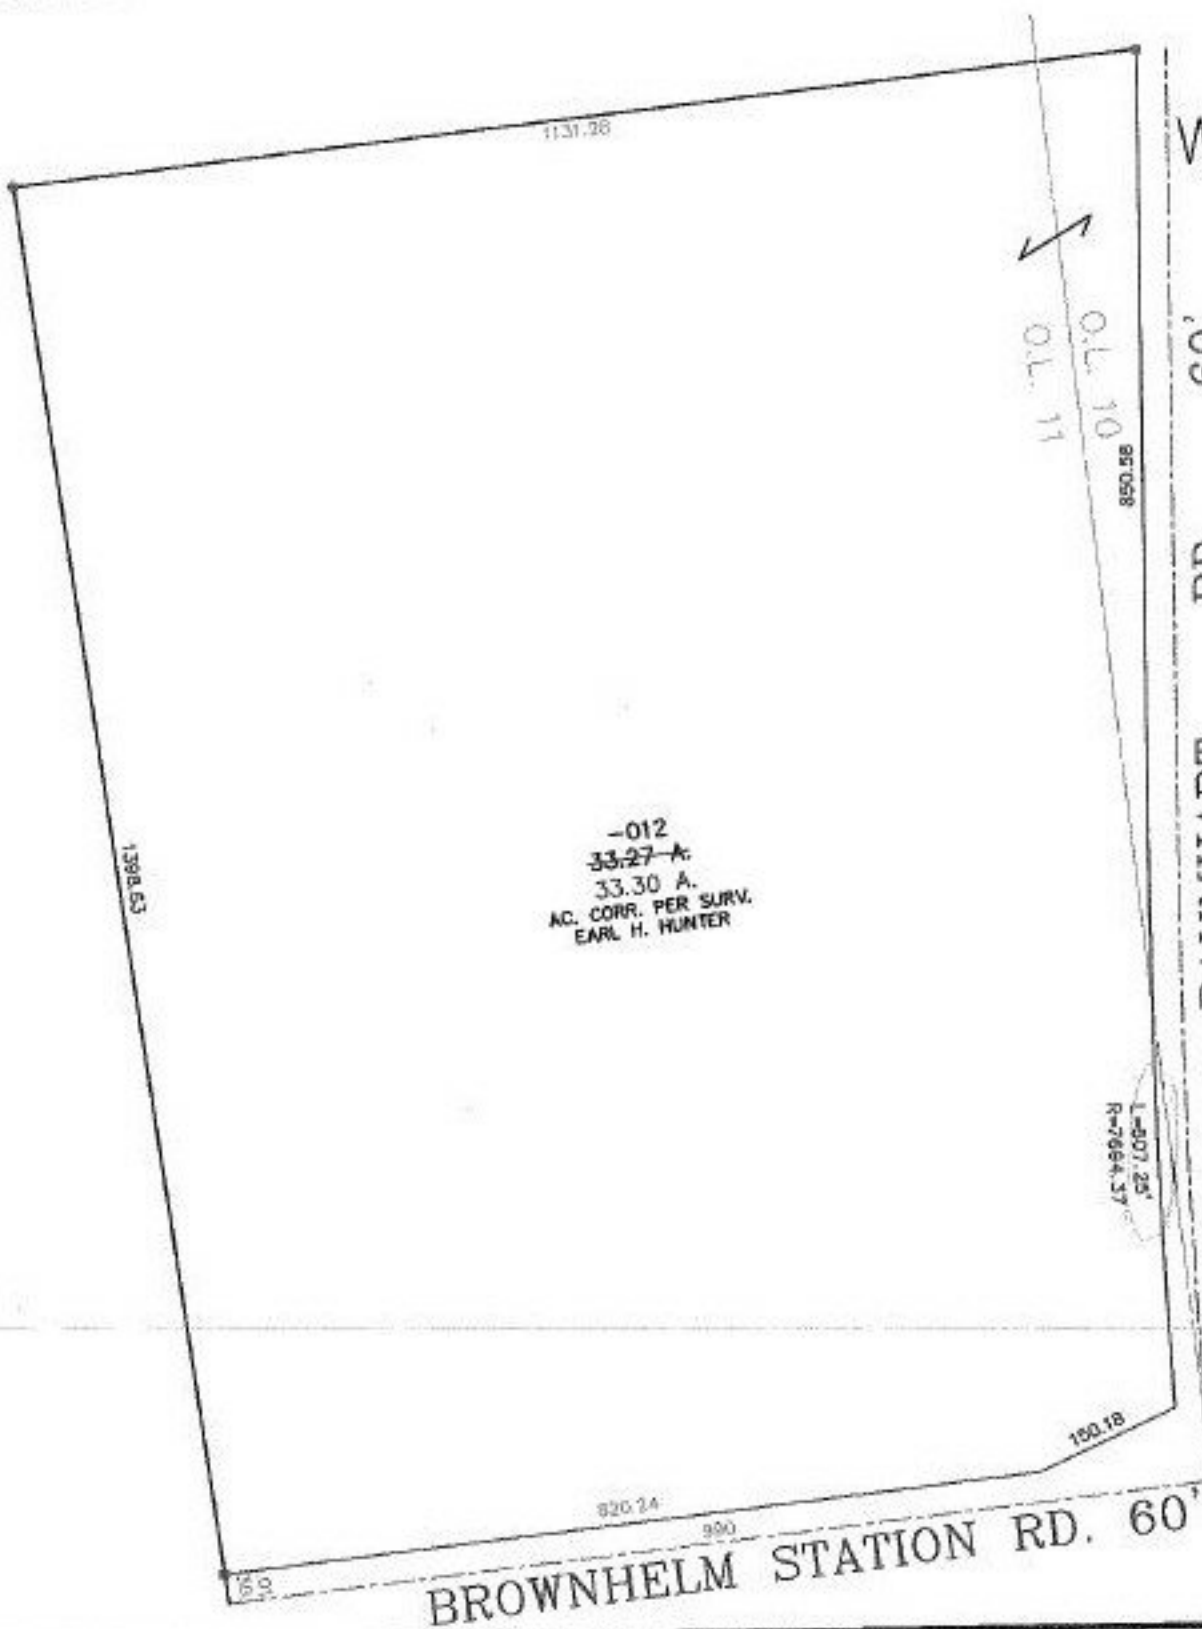

-012  
 33.27-A  
 33.30 A.  
 AC. CORR. PER SURV.  
 EARL H. HUNTER

L=507.25'  
 R=7664.37'



**SPLITS/DEEDS PROCESSED**  
 LORAIN COUNTY TAX MAP DEPARTMENT  
 226 MIDDLE AVE. ELYRIA, OHIO

SURVEYED BY: EARL H. HUNTER  
 CLOSURE: 0.07 : 10.000  
 MAP PAGE(S): 1-C  
 APPROVED BY: TJS DATE: 04/23/99  
 SCALE: 1" = 200' PRIOR INSTRUMENT: DV 1402/537