


PARENT PARCEL: 16-00-043-000-003


CHILD PARCEL: 16-00-043-000-008, -009, -010, -011, -012, -013

STARTING POINT: INT. C.L. 303 AND MENNELL ROAD

NO. 00119

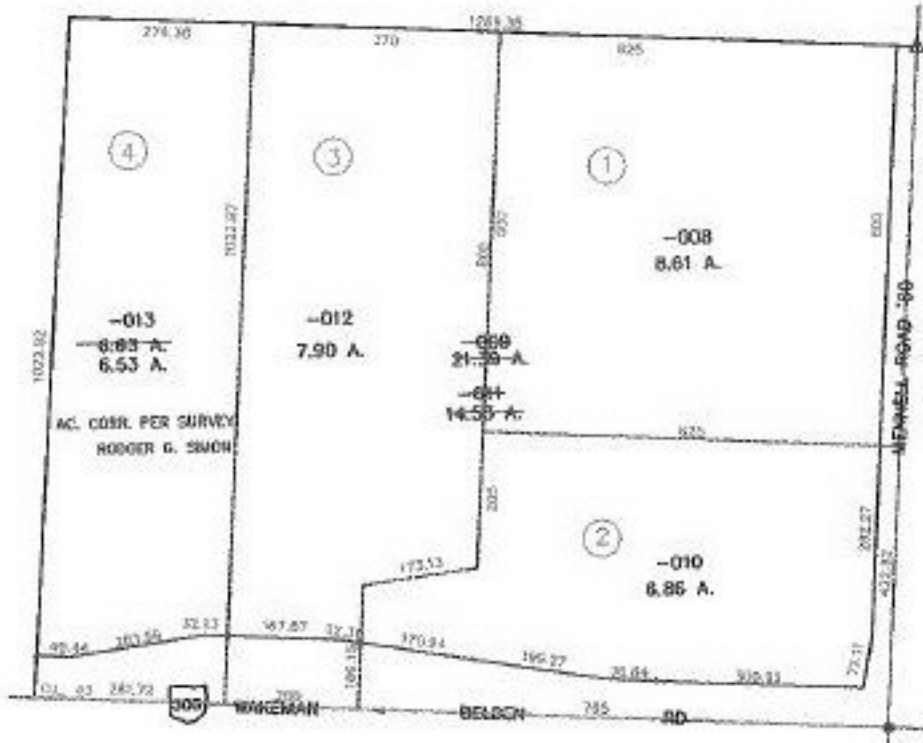

INTERSECTION DETAIL
DETAIL NOT TO SCALE

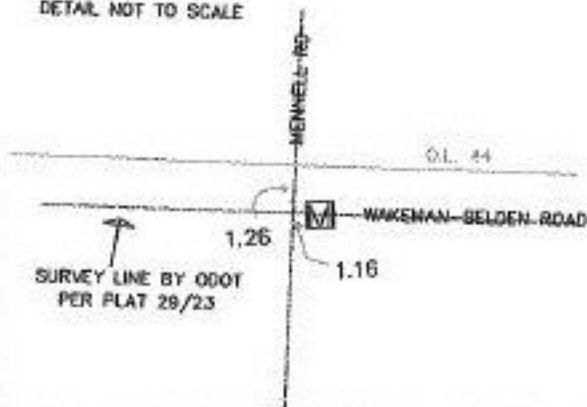

FS
2-22-00

CLOSURE

- ① 1 : INF
- ② 1 : 133,733
- ③ 1 : 183,806
- ④ 1 : 520,380

SURVEYED BY: RODGER G. SIMON

CLOSURE: SEE ABOVE

MAP PAGE(S): 16-A

APPROVED BY: DRH DATE: 6/21/99

SCALE: 1" = 300' PRIOR INSTRUMENT: DV 857/238



SPLITS/DEEDS PROCESSED
LORAIN COUNTY TAX MAP DEPARTMENT
226 MIDDLE AVE. ELYRIA, OHIO