

PARENT PARCEL: 05-00-053-000-010


CHILD PARCEL: XX-XX-XXX-XXX-XXX

STARTING POINT: CL OF OBERLIN RD. & NORTH LINE OF O.L. 53

NO. 00122-X

# MAP CORRECTION ONLY

05-00-053-000-010

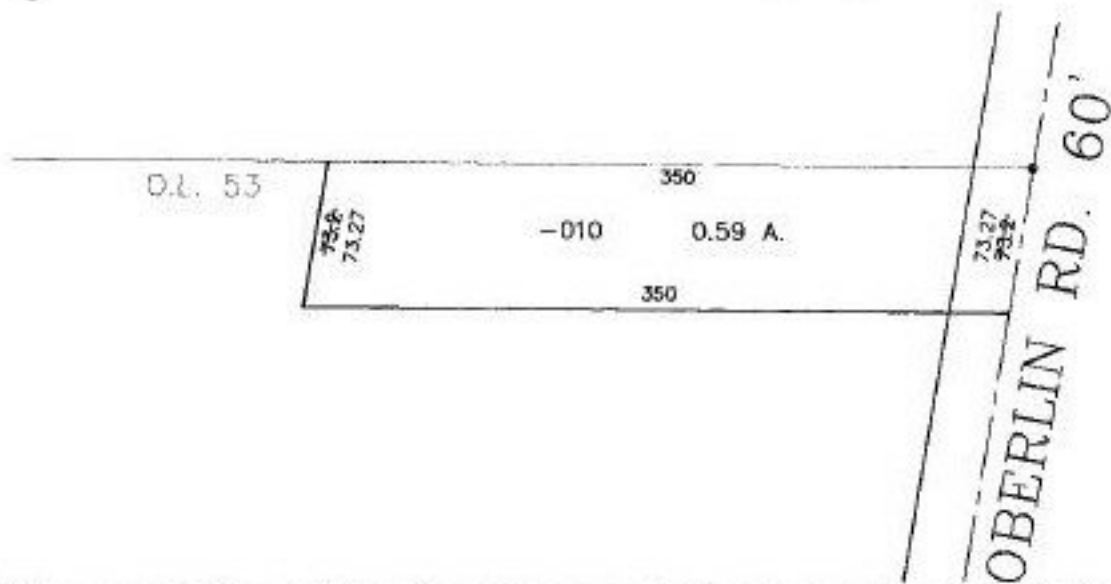

## SPLITS/DEEDS PROCESSED

LORAIN COUNTY TAX MAP DEPARTMENT  
226 MIDDLE AVE. ELYRIA, OHIO

SURVEYED BY: DV 583/499  
 CLOSURE: 0.00 : 10.000  
 MAP PAGE(S): 05-00-053-B  
 APPROVED BY: IJS DATE: 05/17/99  
 SCALE: 1" = 100' PRIOR INSTRUMENT: DV 583/499