
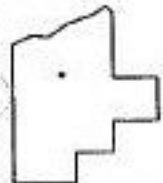


PARENT PARCEL: 07-00-023-102-047

CHILD PARCEL: 07-00-023-102-049, -050

STARTING POINT: CHESTNUT RIDGE ROAD

NO. 00123

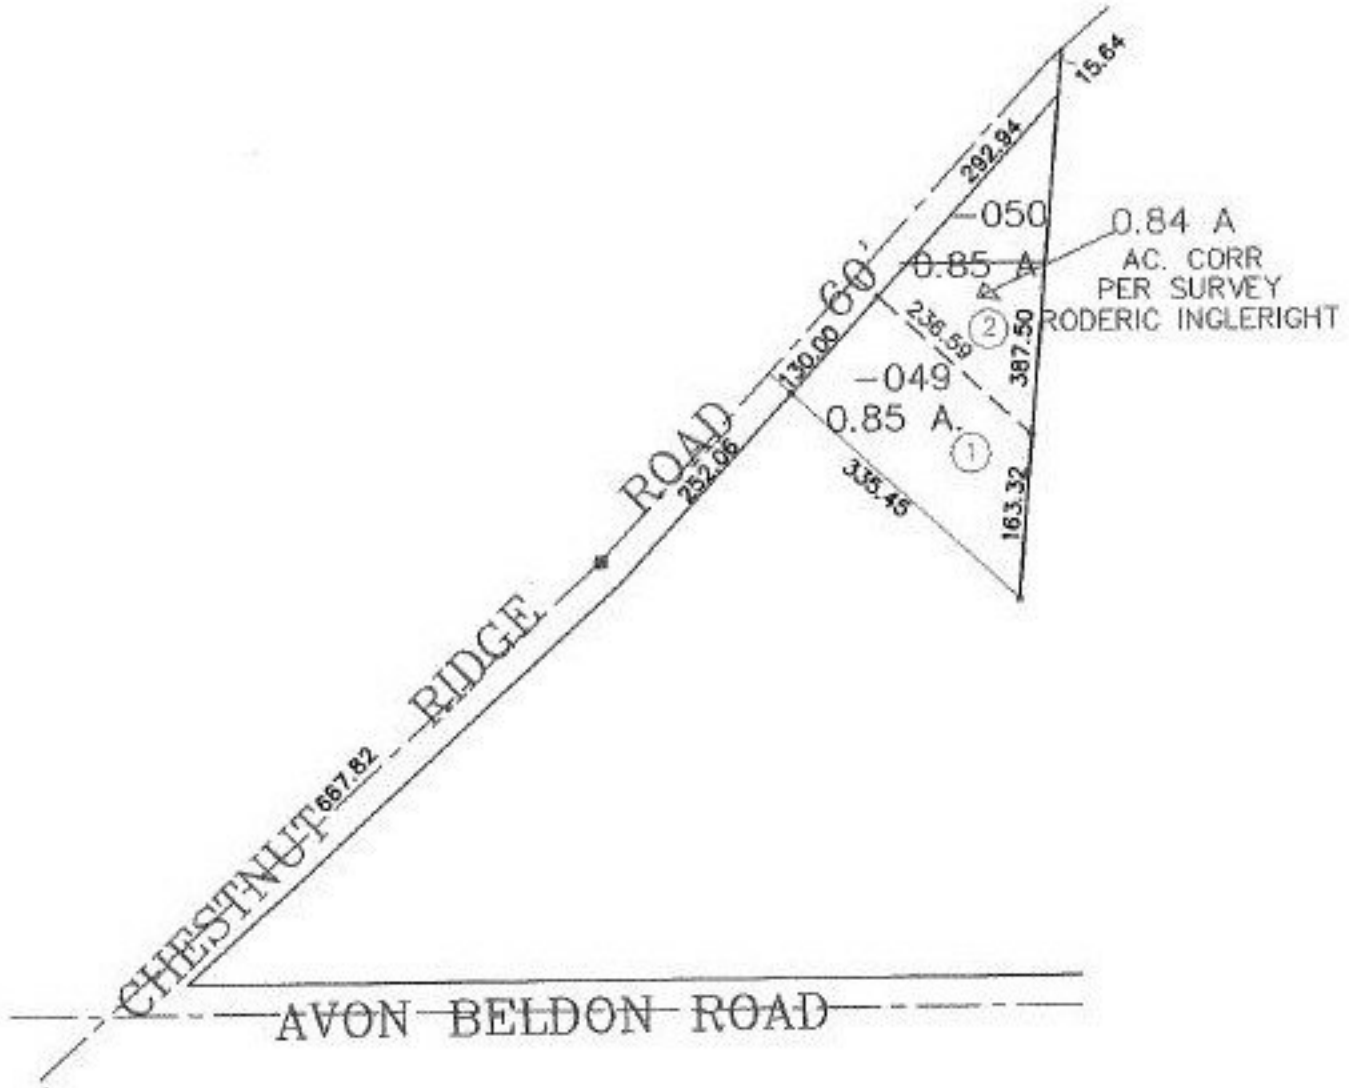

SPLITS/DEEDS PROCESSED
LORAIN COUNTY TAX MAP DEPARTMENT
 226 MIDDLE AVE. ELYRIA, OHIO

SURVEYED BY: RODERIC INGLERIGHT
 CLOSURE: 0.01 : 10.000
 MAP PAGE(S): 07-00-023-C
 APPROVED BY: DRH DATE: 6/21/99
 SCALE: 1" = 200' PRIOR INSTRUMENT: 990601269

Handwritten initials/signature