
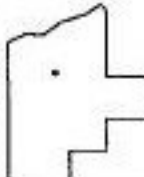


PARENT PARCEL: 07-00-028-103-122

CHILD PARCEL: 07-00-028-103-124, -125

STARTING POINT: INT C.L. MADDOCK RD AND C.L. CENTER RIDGE ROAD

NO. 00125

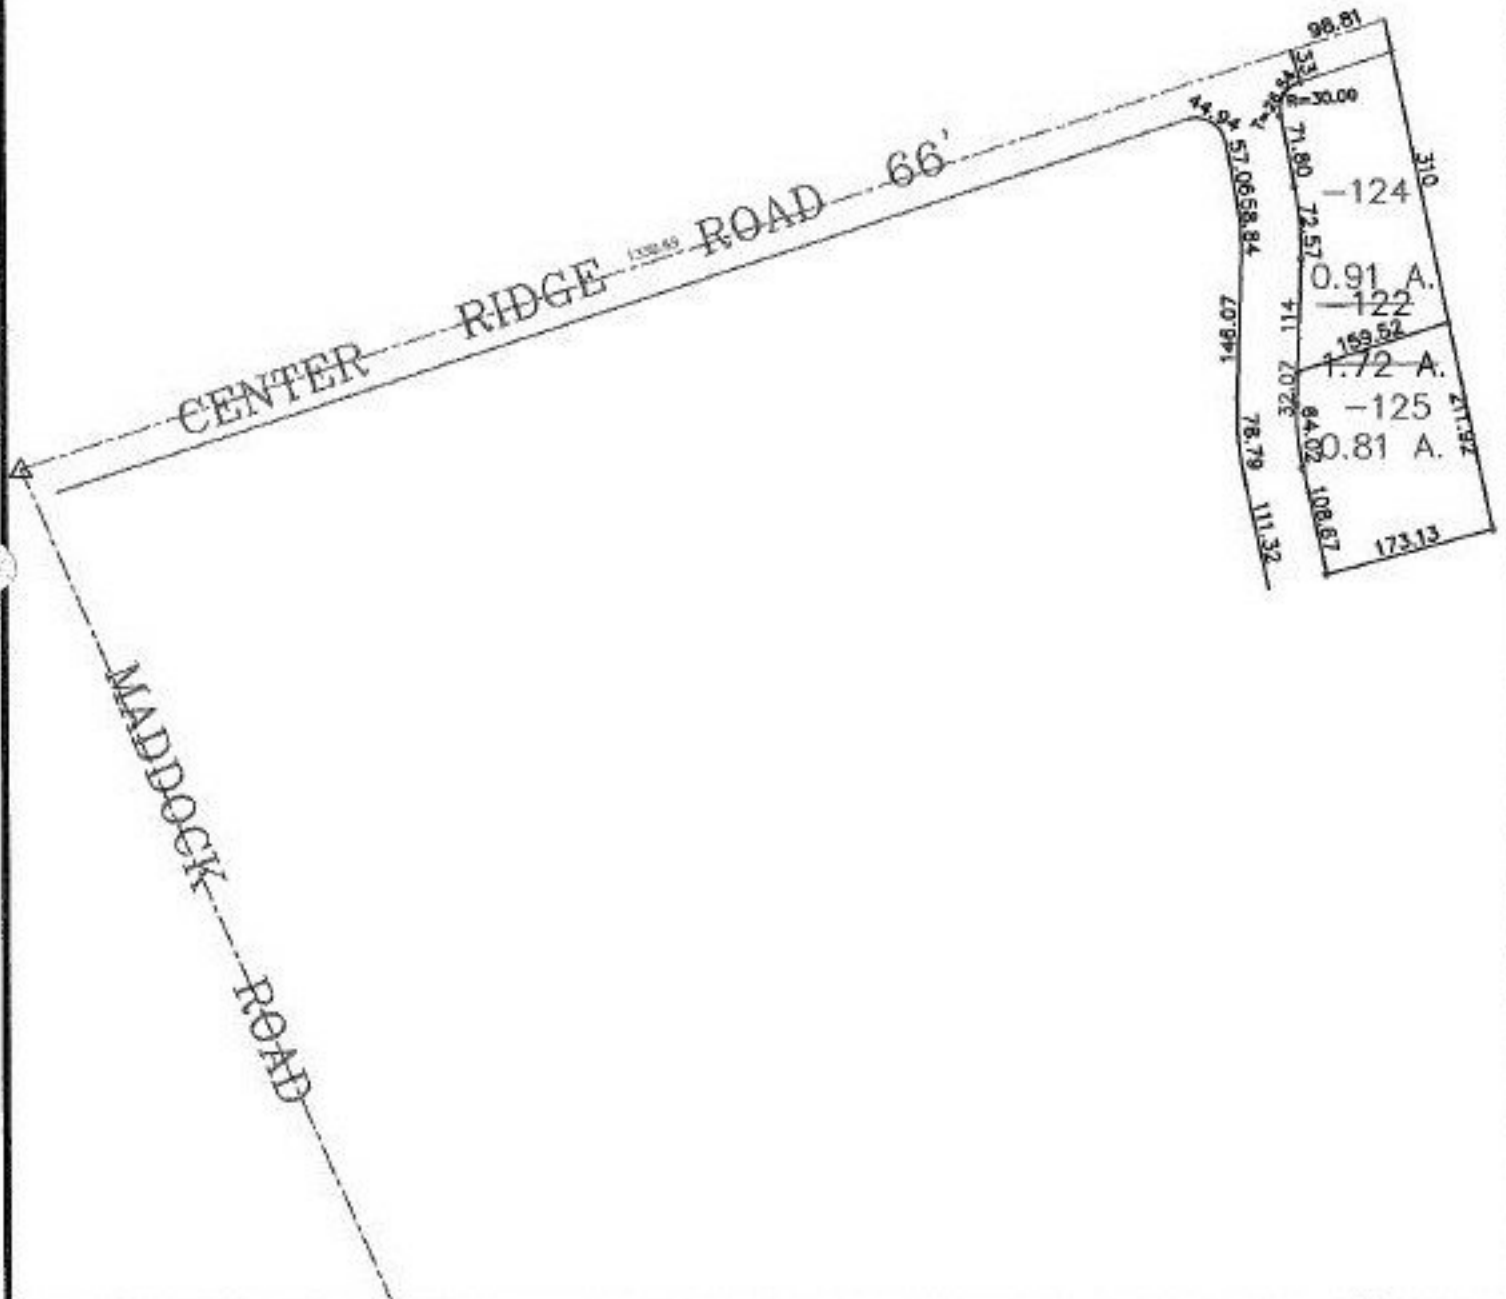

**SPLITS/DEEDS PROCESSED**

LORAIN COUNTY TAX MAP DEPARTMENT  
226 MIDDLE AVE. ELYRIA, OHIO

SURVEYED BY: DAVID L. FLEWELL  
 CLOSURE: 0.03 : 10,000  
 MAP PAGE(S): 7-00-028-C  
 APPROVED BY: DRH DATE: 06/22/1999  
 SCALE: 1" = 200' PRIOR INSTRUMENT: OR 1186/872