
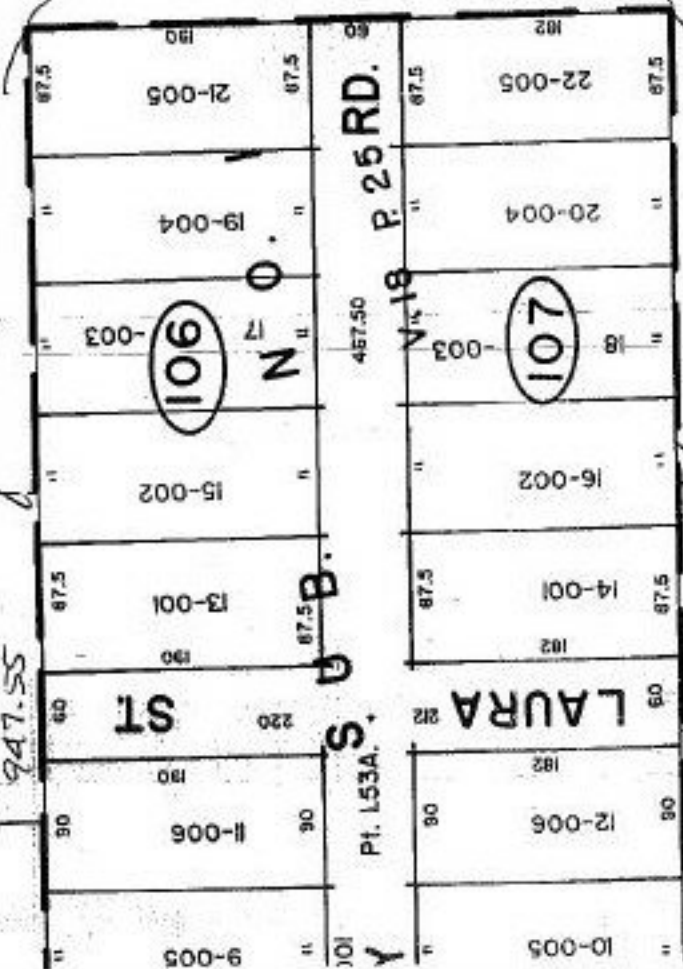


SEE 4-00-027-F

1853.56

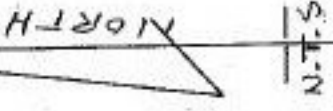

108  
-040  
61.68A.

40-69 P.

99-00128

Combination

APPROVED LORAIN CO. MAP DEPT.	DATE 6.9.99	PAGE 4.00.026	BY T. McMain	99-00128
-------------------------------------	-------------	---------------	--------------	----------

1046-45 1040.47

749.9

-A.