


PARENT PARCEL: 02-01-008-101-132, -142, & -143
CHILD PARCEL: XX-XX-XXX-XXX-XXX
STARTING POINT: CL. OF OBERLIN RD. & CL. OF WESTWOOD DR.

NO. 00128-D

DEED CHECK

02-01-008-101-132 OK
1.35 A.
02-01-008-101-142 OK
0.16 A.
02-01-008-101-143 OK
0.65 A.

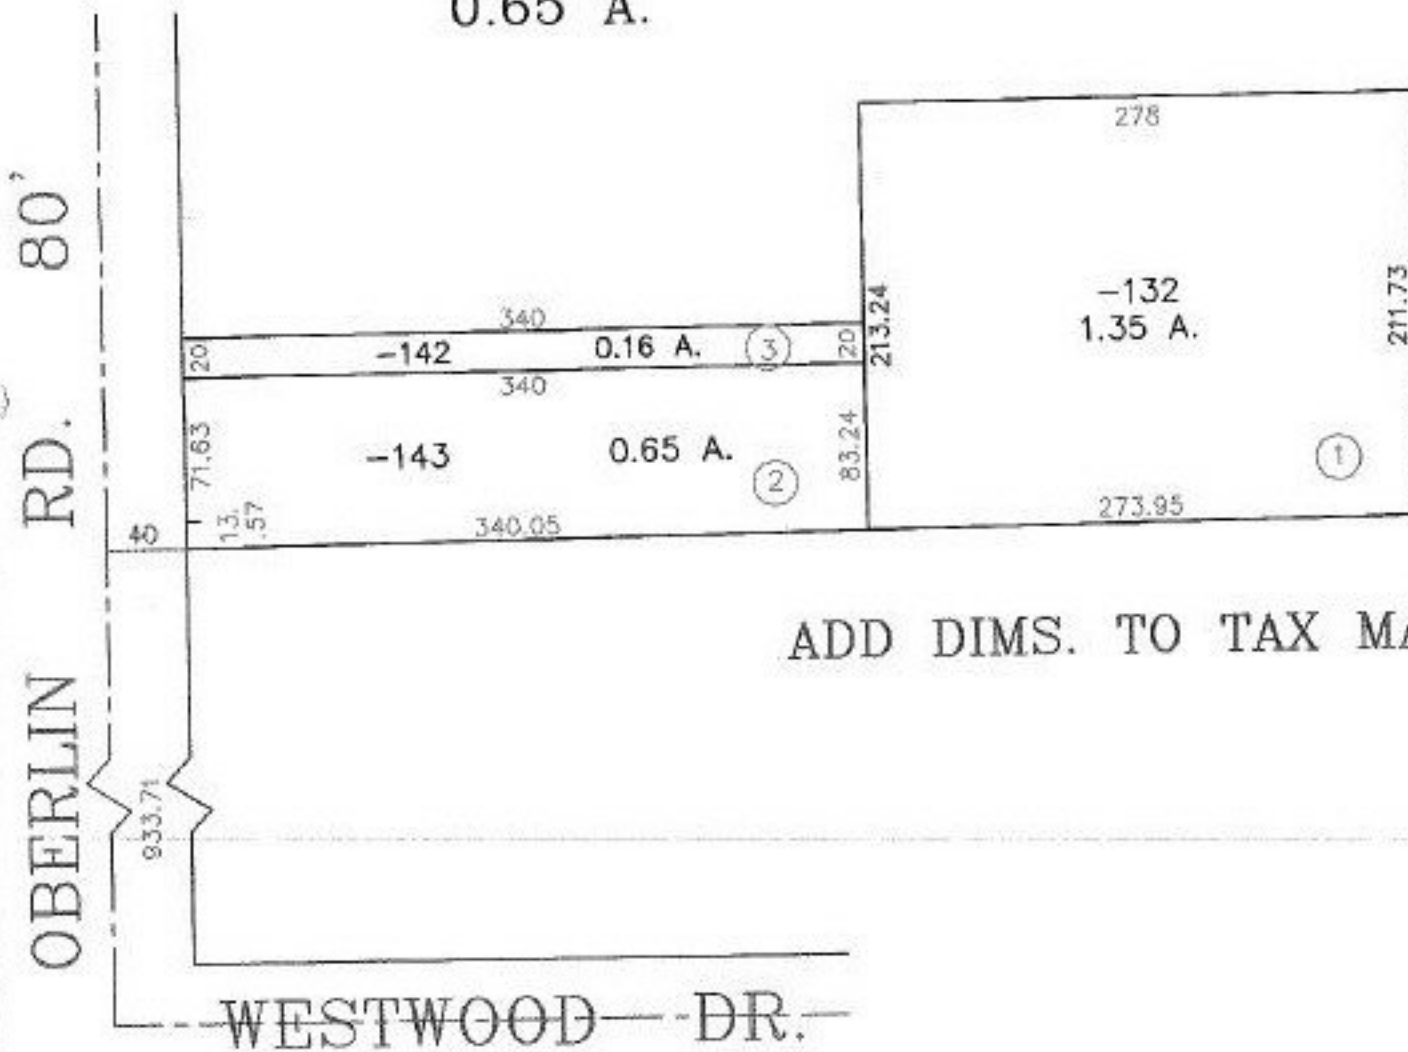

ADD DIMS. TO TAX MAP

SPLITS/DEEDS PROCESSED

LORAIN COUNTY TAX MAP DEPARTMENT
226 MIDDLE AVE. ELYRIA, OHIO

SURVEYED BY: NONE
CLOSURE: 0.19 : 10,000
MAP PAGE(S): 02-01-008-A
APPROVED BY: TJS DATE: 05/04/99
SCALE: 1" = 100' PRIOR INSTRUMENT: OR 1208/766