


#00128

Combination

108-040
61.68 Ac.

Pt. ~~108-002~~
Pt. 25.82 Ac.

THIS HEAVY LINE IS THE
WEST EDGE OF DV. 18, P. 25

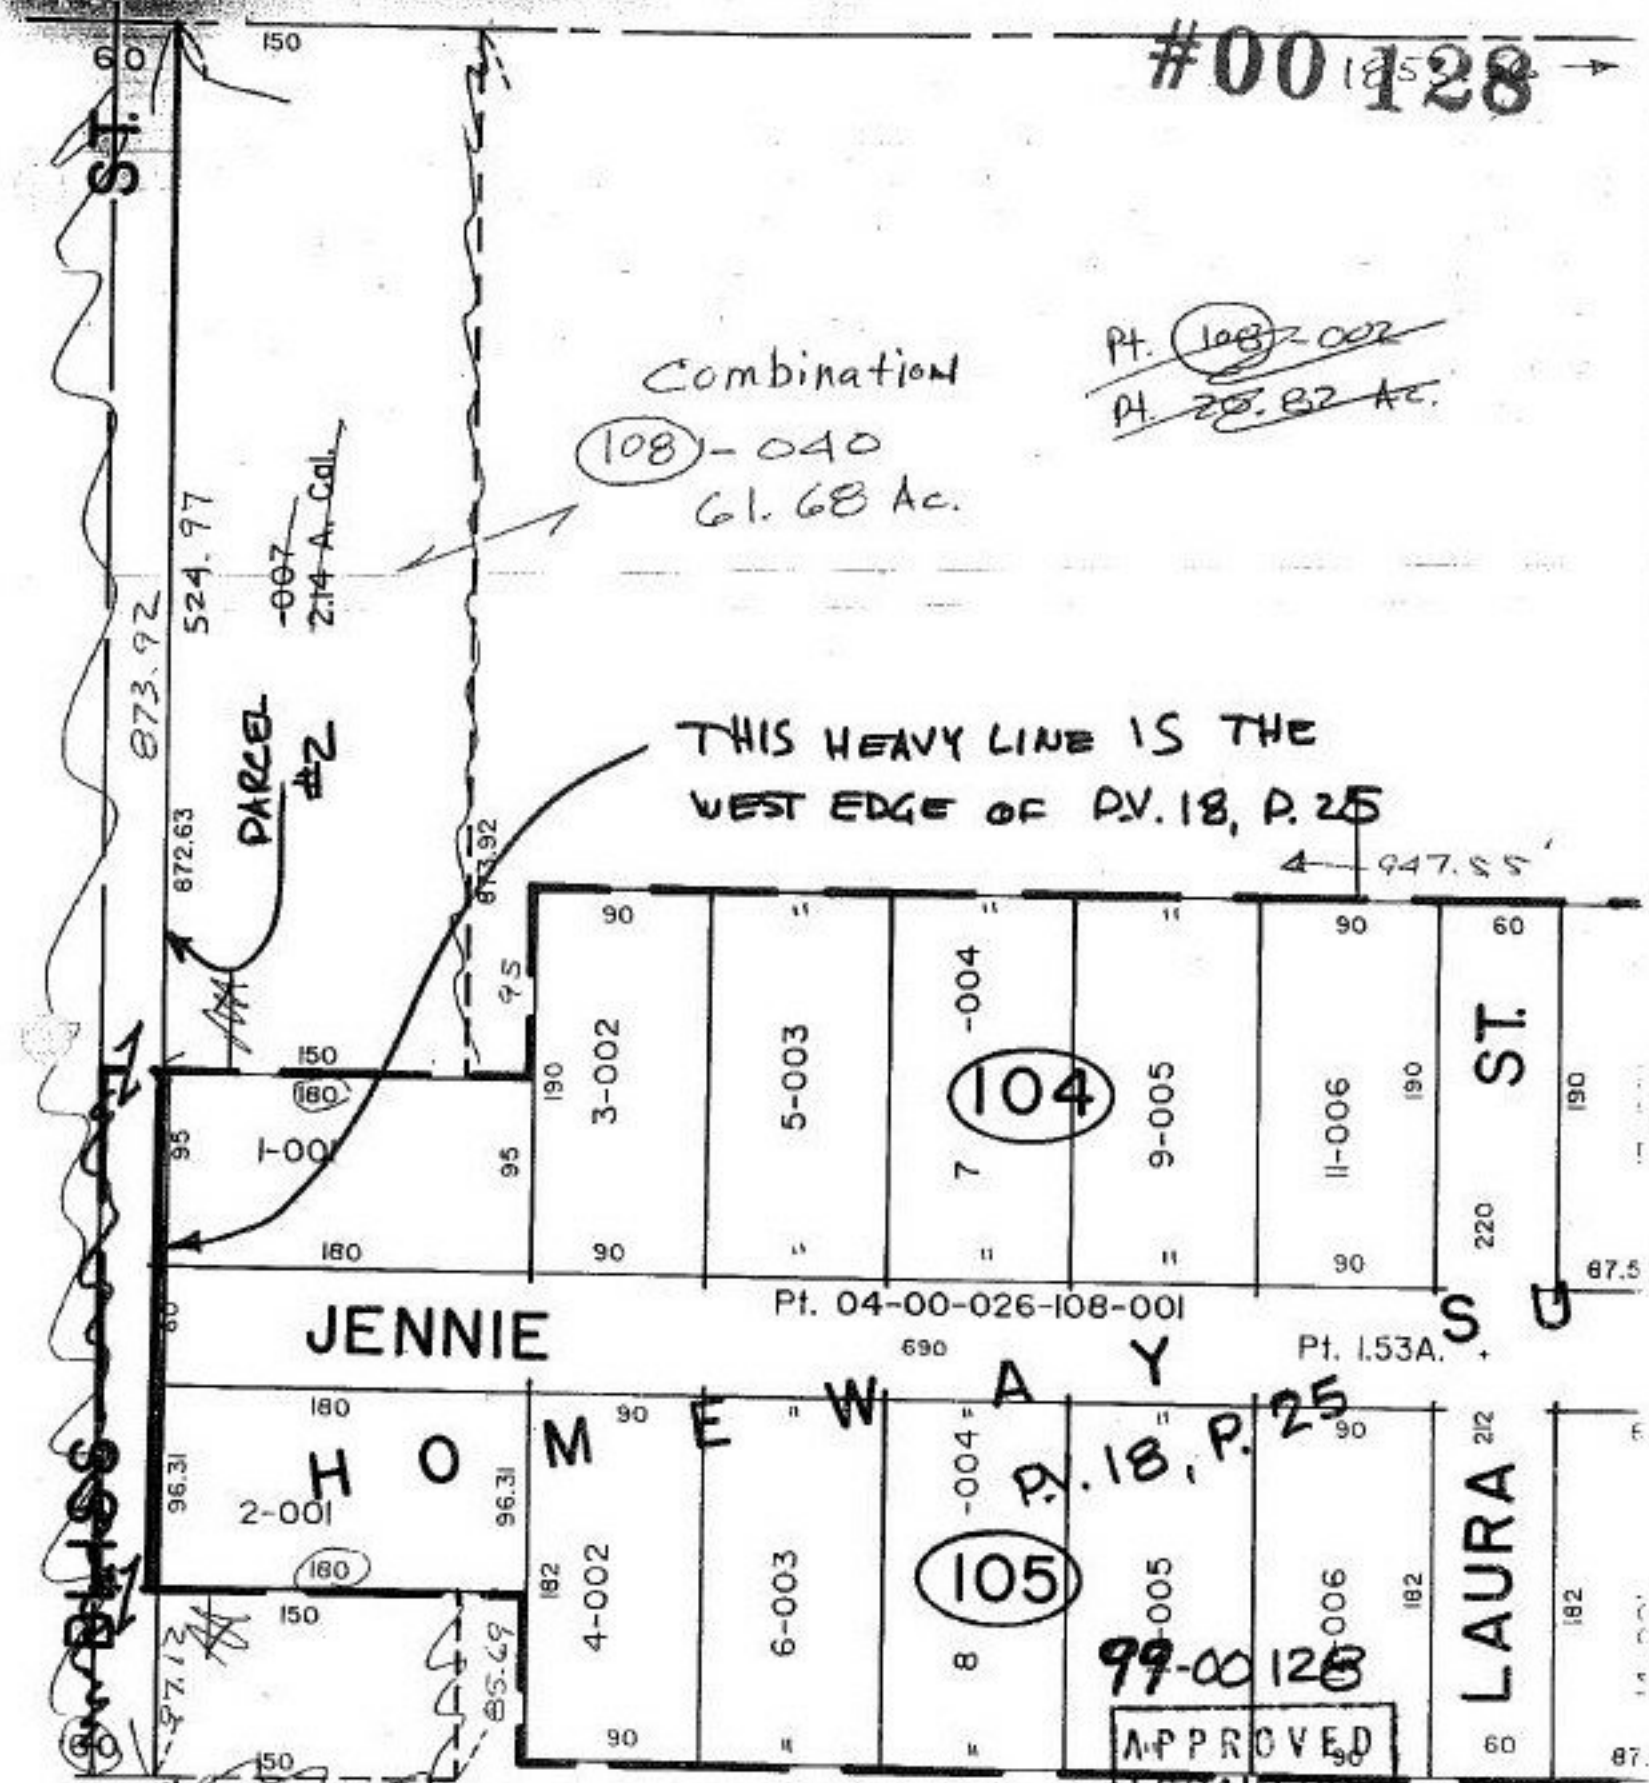

APPROVED
LORAIN CO.
MAP DEPT.
DATE 6.9.99 ✓
Pt. 400.026B
BY T. McHain
99.00128

Comb.

820.33

947.55

ST.

LAURA

JENNIE

H O M E

W A Y

104

105

99-00128

P. 18, P. 25

Pt. 04-00-026-108-001

Pt. 153A.

S U

873.92
524.97
-007
214 A. Cal.

PARCEL #2

872.63


95
180

60
180

96.31
2-001

150
87.12

150
126

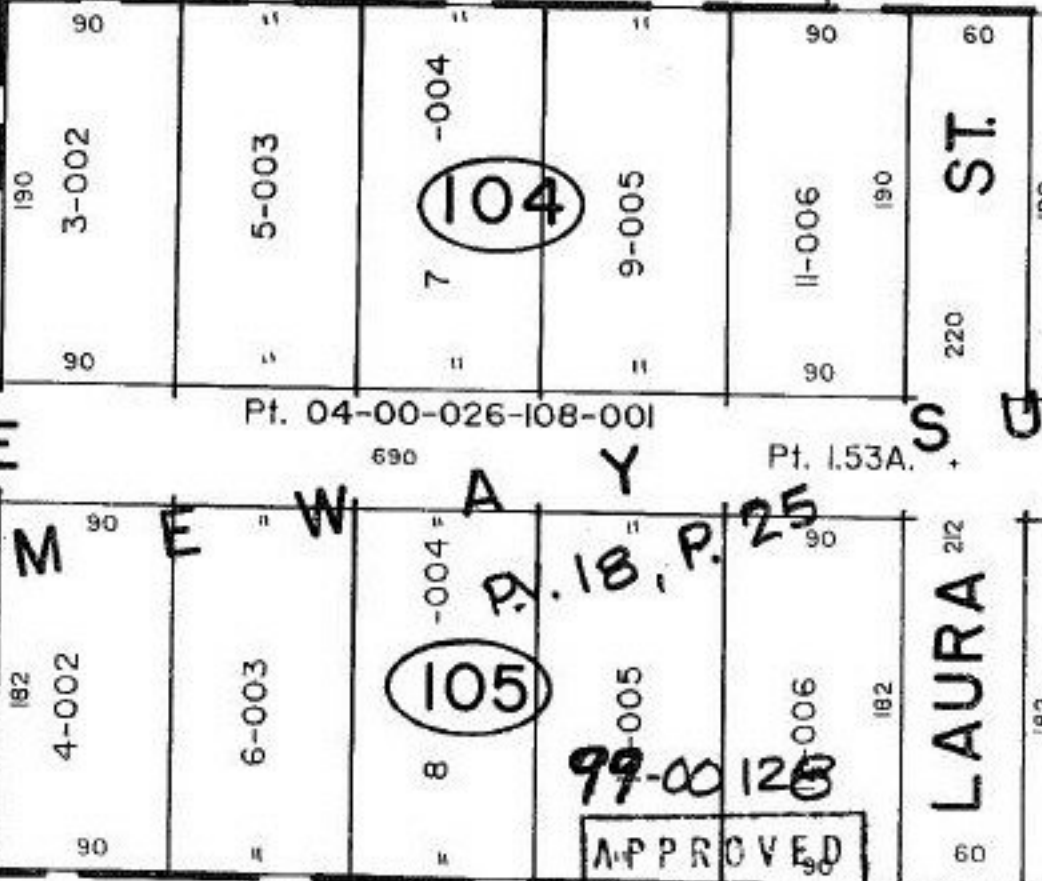

947.55

190
220
67.5

182
60
87.5