


#00 130-D

SEE 4-00-027-E

NW CORNER Sec. 29 145.00

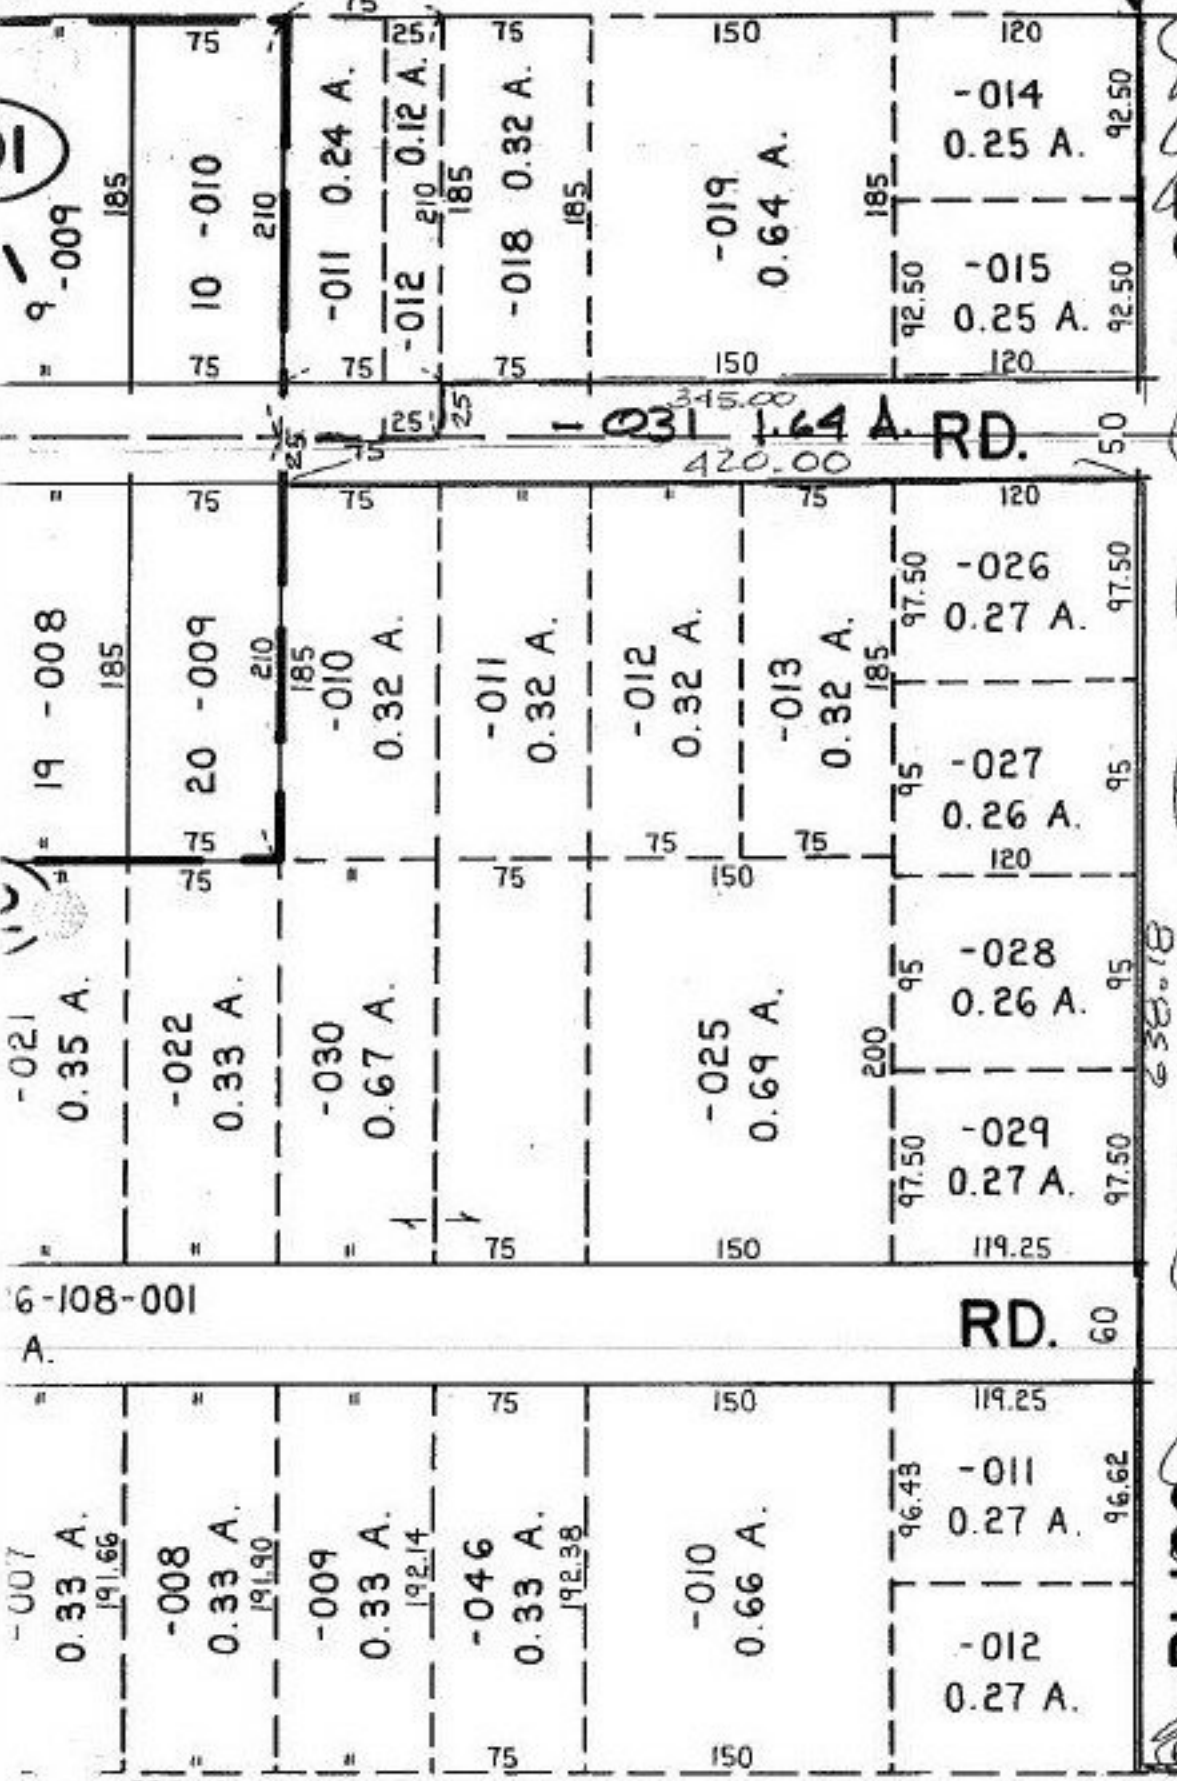

PARCEL #2

TAKE THIS STREET OFF OF TAX MAP, AS IT WAS NEVER A DEDICATED STREET WITHIN HOMEWAY SUB. REFERENCE TO BLISS ST. APPEARS IN P. 18, P. 25

ADD TO DUPLICATE 99-00130-D

APPROVED
 LORAIN CO.
 MAP DEPT.
 DATE 6.9.99
 1.00.026-A
 T. M. Main
 99-00130-1

BLISS