


PARENT PARCEL: 01-00-033-000-004, -032

CHILD PARCEL: 01-00-033-000-051, -052

STARTING POINT: I.P. CL. WEST RIVER ROAD 626.45 FROM I.P. INT OF DARROW

NO. 00130

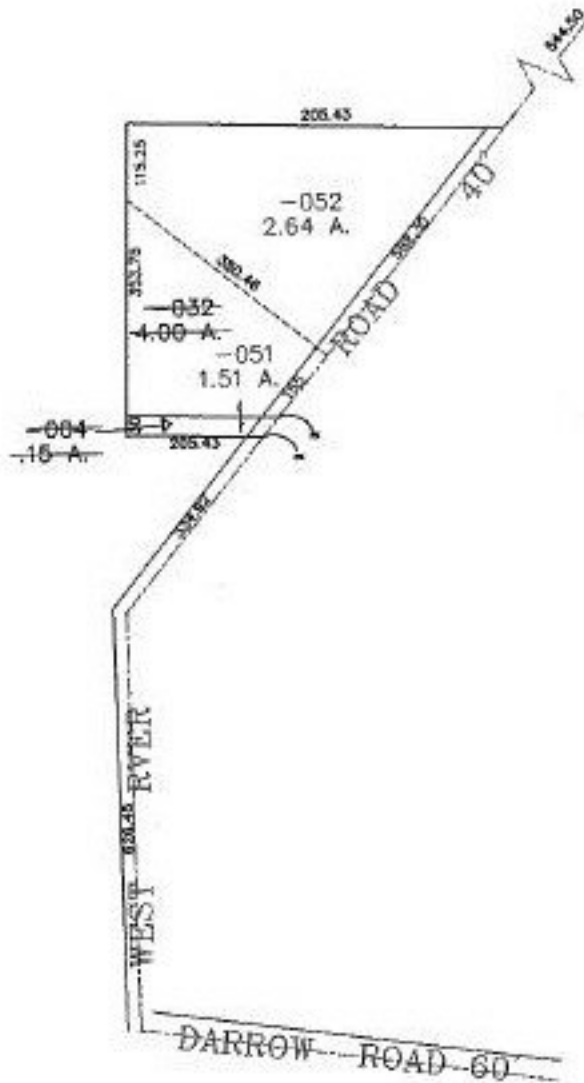

PRIOR INSTRUMENT: DV 1154/0078
 DV 1154/0080
 OR 1393/0305

SURVEYED BY: MICHAEL G. HURA
 CLOSURE: 0.03 : 10,000
 MAP PAGE(S): 1-E
 APPROVED BY: DRH DATE: 6/23/99
 SCALE: 1" = 300'

SPLITS/DEEDS PROCESSED
 LORAIN COUNTY TAX MAP DEPARTMENT
 226 MIDDLE AVE. ELYRIA, OHIO