


PARENT PARCEL: 04-00-021-000-168

CHILD PARCEL: 04-00-021-000-175, 176

STARTING POINT: MON. BOX, CL. OF JAYCOX RD. & CL. OF CHESTER RD.

NO. 00132

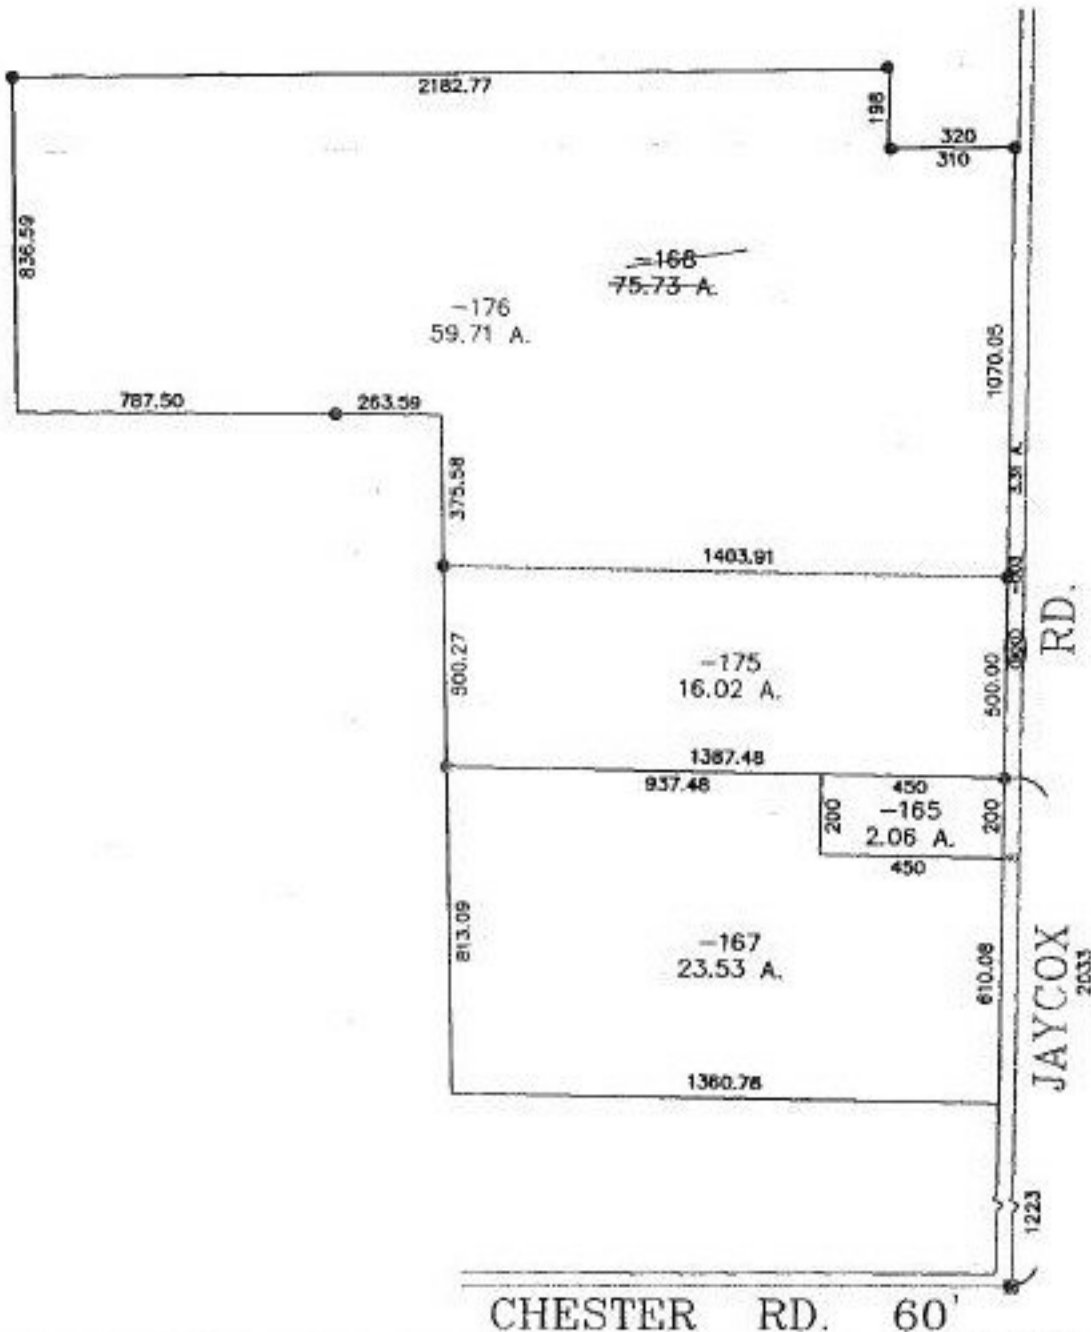

SPLITS/DEEDS PROCESSED

LORAIN COUNTY TAX MAP DEPARTMENT
226 MIDDLE AVE. ELYRIA, OHIO

SURVEYED BY: DONALD E. HIMES
 CLOSURE: 0.01 : 10,000
 MAP PAGE(S): 4-G
 APPROVED BY: DRH DATE: 6/25/99
 SCALE: 1" = 500' PRIOR INSTRUMENT: 980538176