

PARENT PARCEL: 16-00-079-000-031

CHILD PARCEL: XX-XX-XXX-XXX-XXX

STARTING POINT: I.P. IN THE CL. OF LAW RD. & N.E. CORNER OF O.L. 79

NO. 00134-A



# ACREAGE CORRECTION DUP. ONLY



16-00-079-000-031

~~0.15 A.~~

0.54 A.

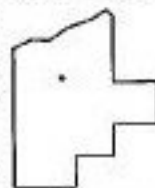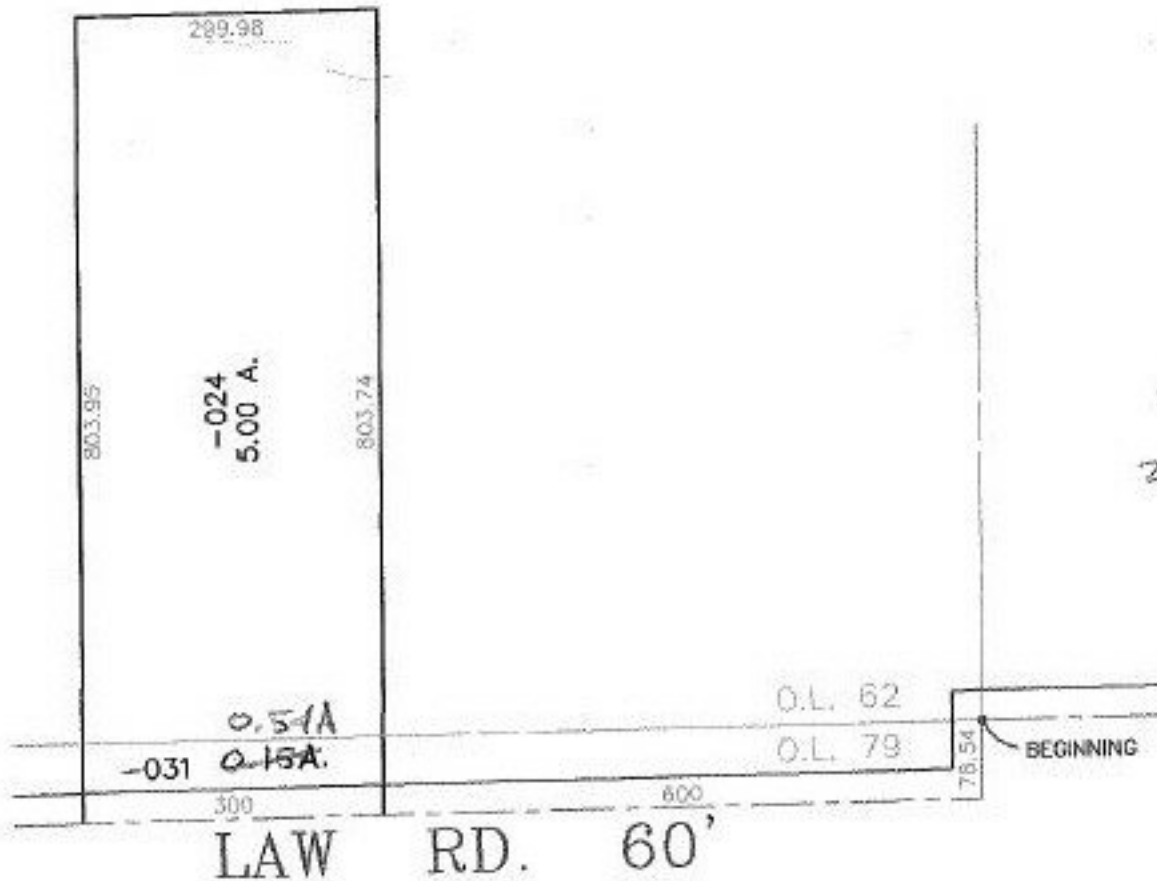

**SPLITS/DEEDS PROCESSED**  
LORAIN COUNTY TAX MAP DEPARTMENT  
226 MIDDLE AVE. ELYRIA, OHIO

SURVEYED BY: NONE  
CLOSURE: 13.72 : 10.000  
MAP PAGE(S): 16-00-062-B  
APPROVED BY: I. SPILLMAN DATE: 07/27/99  
SCALE: 1" = 200' PRIOR INSTRUMENT: DV 1342/668