

PARENT PARCEL: 09-00-074-101-042, -029


CHILD PARCEL: 09-00-074-101-046, -047, -048

STARTING POINT: INT C.L. WEST LORAIN AND C.L. PYLE SOUTH AMHERST

NO. 00134



PYLE SOUTH AMHERST ROAD 60'

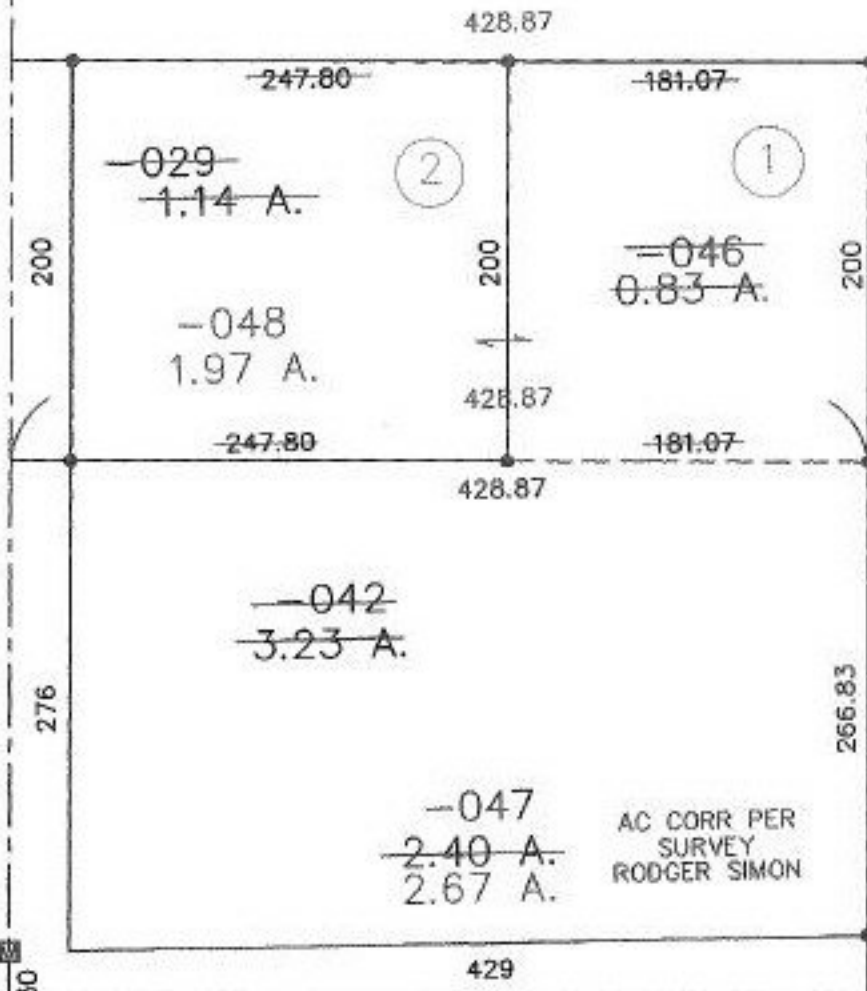

WEST LORAIN ST

TS
2-14-00



SPLITS/DEEDS PROCESSED

LORAIN COUNTY TAX MAP DEPARTMENT
226 MIDDLE AVE. ELYRIA, OHIO

SURVEYED BY: RODGER G. SIMON

CLOSURE: 0.00 : 10.000

MAP PAGE(S): 09-00-074-A

APPROVED BY: DRH DATE: 7/12/99

SCALE: 1" = 100' PRIOR INSTRUMENT: #571072