

PARENT PARCEL: 06-24-099-000-026 & -028

CHILD PARCEL: XXXXXXXXXXXX

STARTING POINT: PARCEL 1: NORTH LINE OF TURNER ST. & WEST LINE OF W. RIVER RD.

PARCEL 2: SOUTH LINE OF TURNER ST. & WEST LINE OF W. RIVER RD.

PARCEL 3: OLD CL OF 2ND ST. & OLD CL OF W. RIVER RD.


NO. 00139-D



DEED CHECK

06-24-099-000-026 OK

06-24-099-000-028 OK

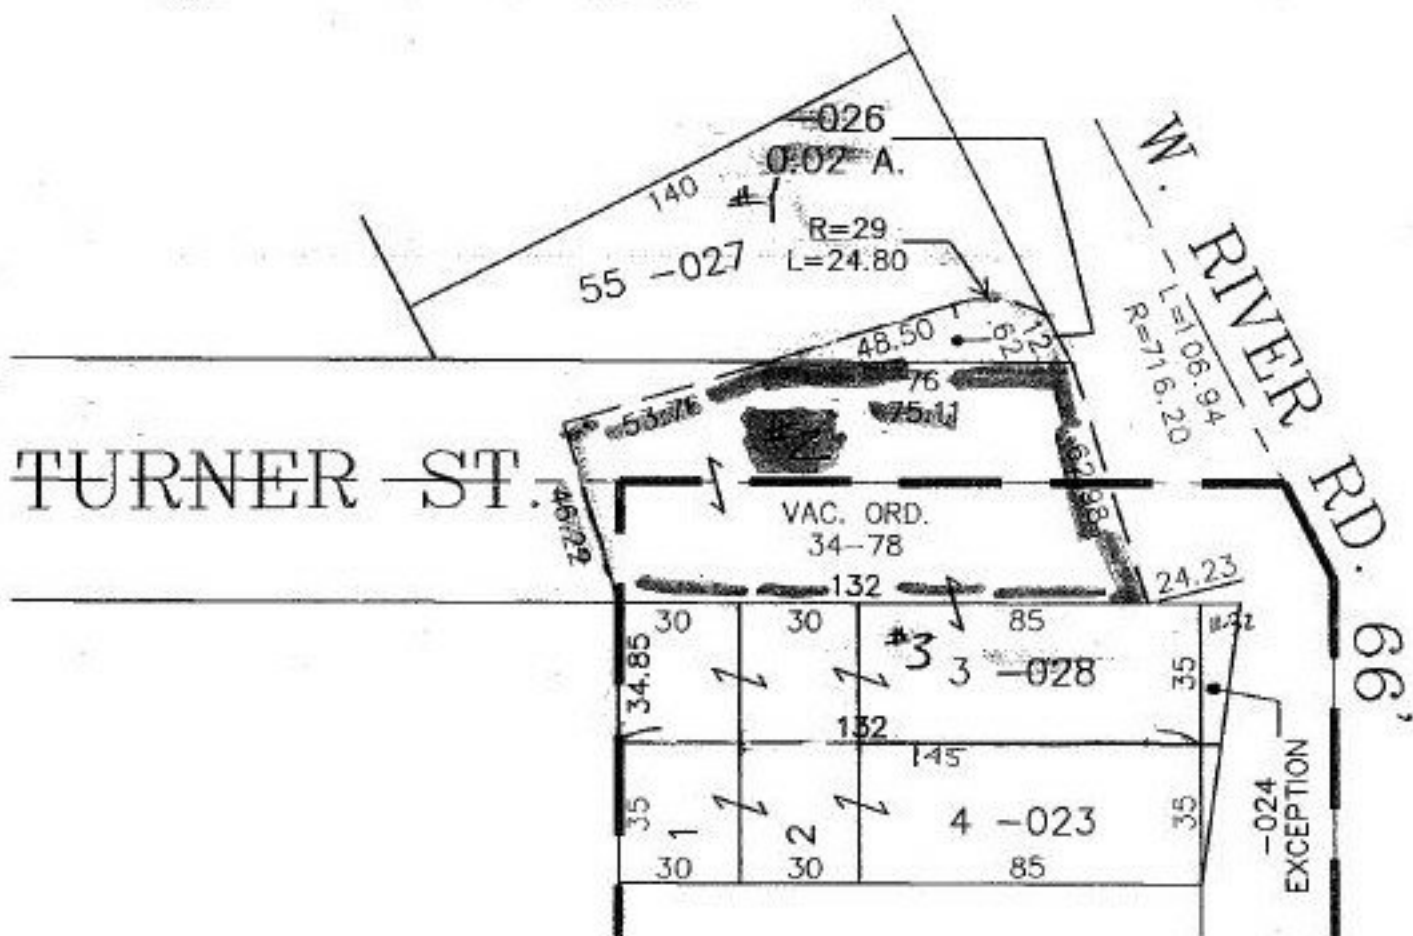

SPLITS/DEEDS PROCESSED

LORAIN COUNTY TAX MAP DEPARTMENT
226 MIDDLE AVE. ELYRIA, OHIO

SURVEYED BY: NONE
 CLOSURE: 0.52 : 10.000
 MAP PAGE(S): 6-117
 APPROVED BY: I. SPILLMAN DATE: 07/29/99
 SCALE: 1" = 50' PRIOR INSTRUMENT: 990617684