


PARENT PARCEL: 01-00-056-000-027, -028, -026, 01-00-056-000-043

CHILD PARCEL: 01-00-056-000-044 THRU -047, 01-00-058-000-018 & 01-00-057-000-013

NO. 00140

STARTING POINT: C.L. MIDDLE RIDGE INT E LINE O.L. 56

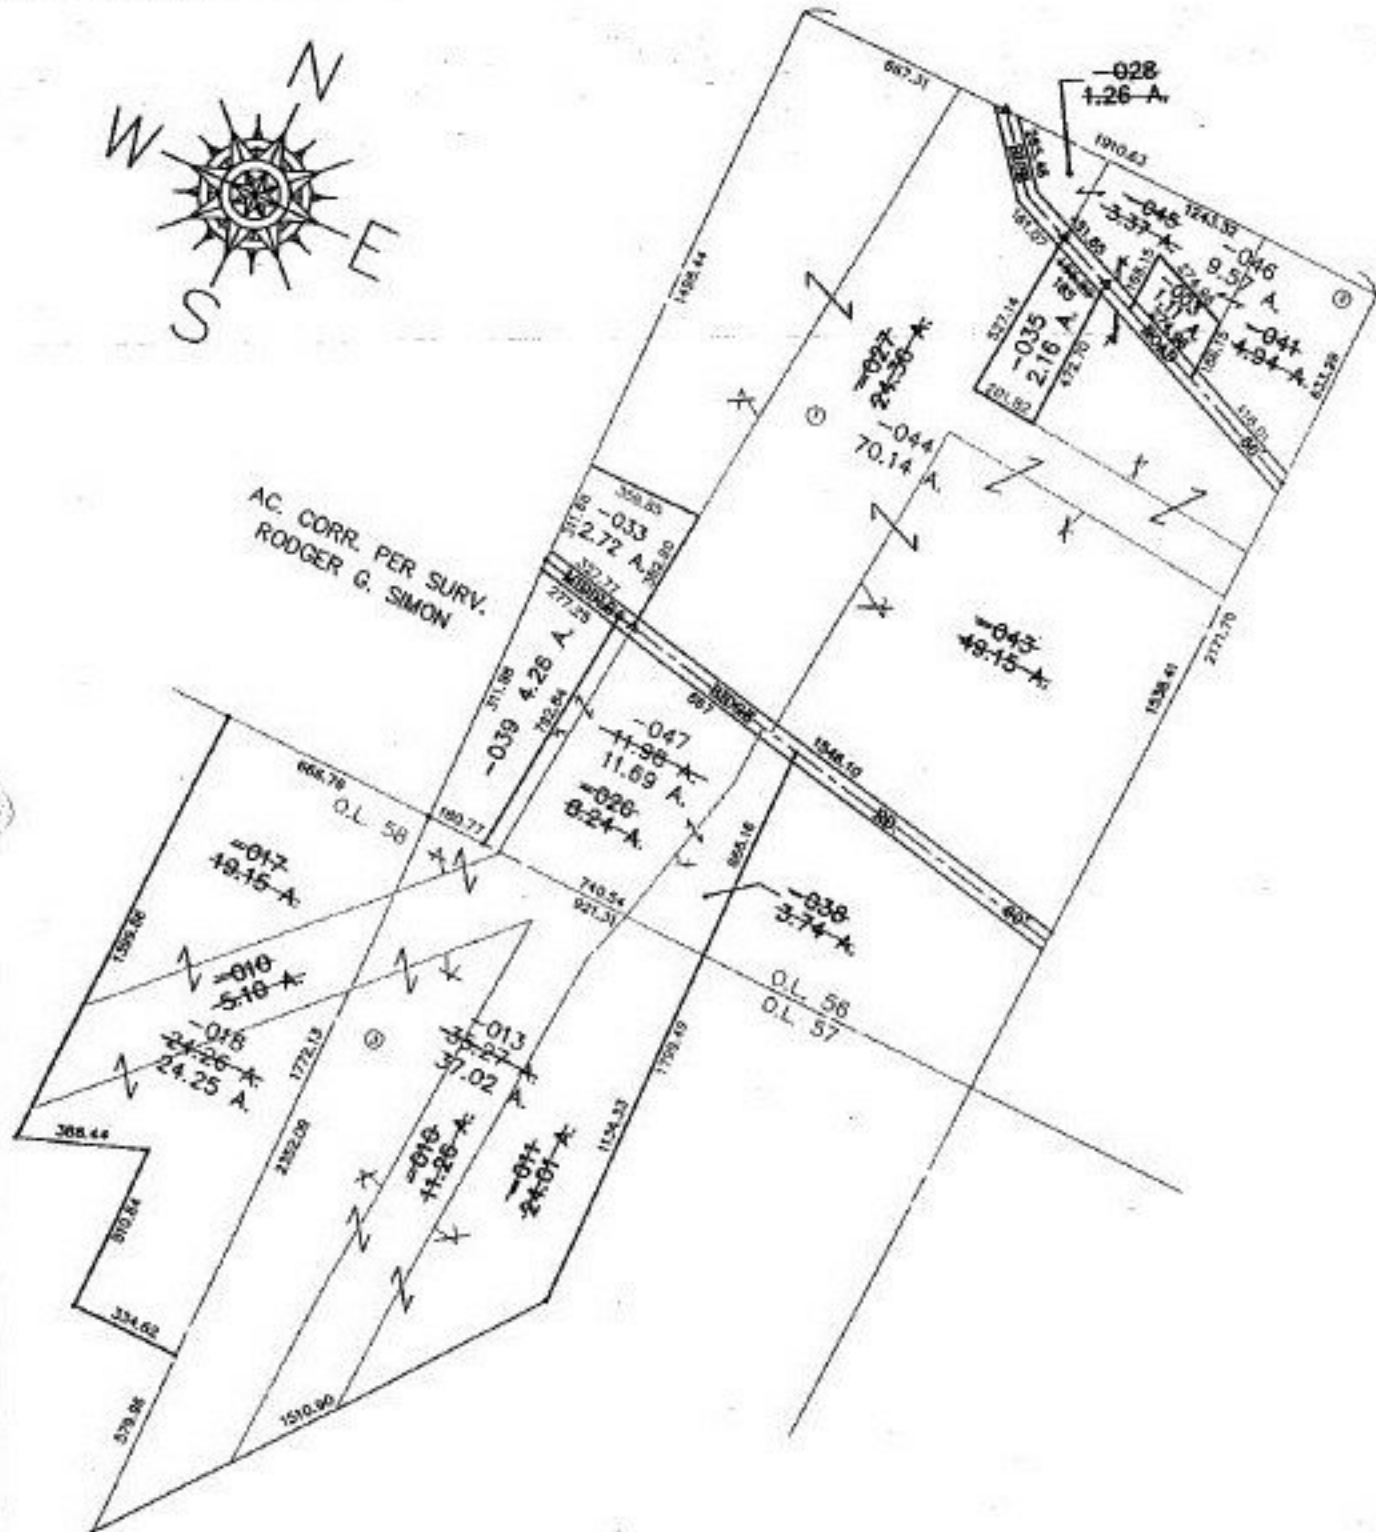

SPLITS/DEEDS PROCESSED
LORAIN COUNTY TAX MAP DEPARTMENT
226 MIDDLE AVE. ELYRIA, OHIO

SURVEYED BY: RODGER G. SIMON

CLOSURE: 0.02 : 10.000

MAP PAGE(S): 1-1

APPROVED BY: DRH & TJS DATE: 7/8/99

SCALE: 1" = 600' PRIOR INSTRUMENT: #980517805