


PARENT PARCEL: 16-00-075-000-009, 008

CHILD PARCEL: XX-XX-XXX-XXX-XXX


STARTING POINT: WOOSTER- AVON LAKE ROAD (ST. RTE. 83)

NO. 00142-D

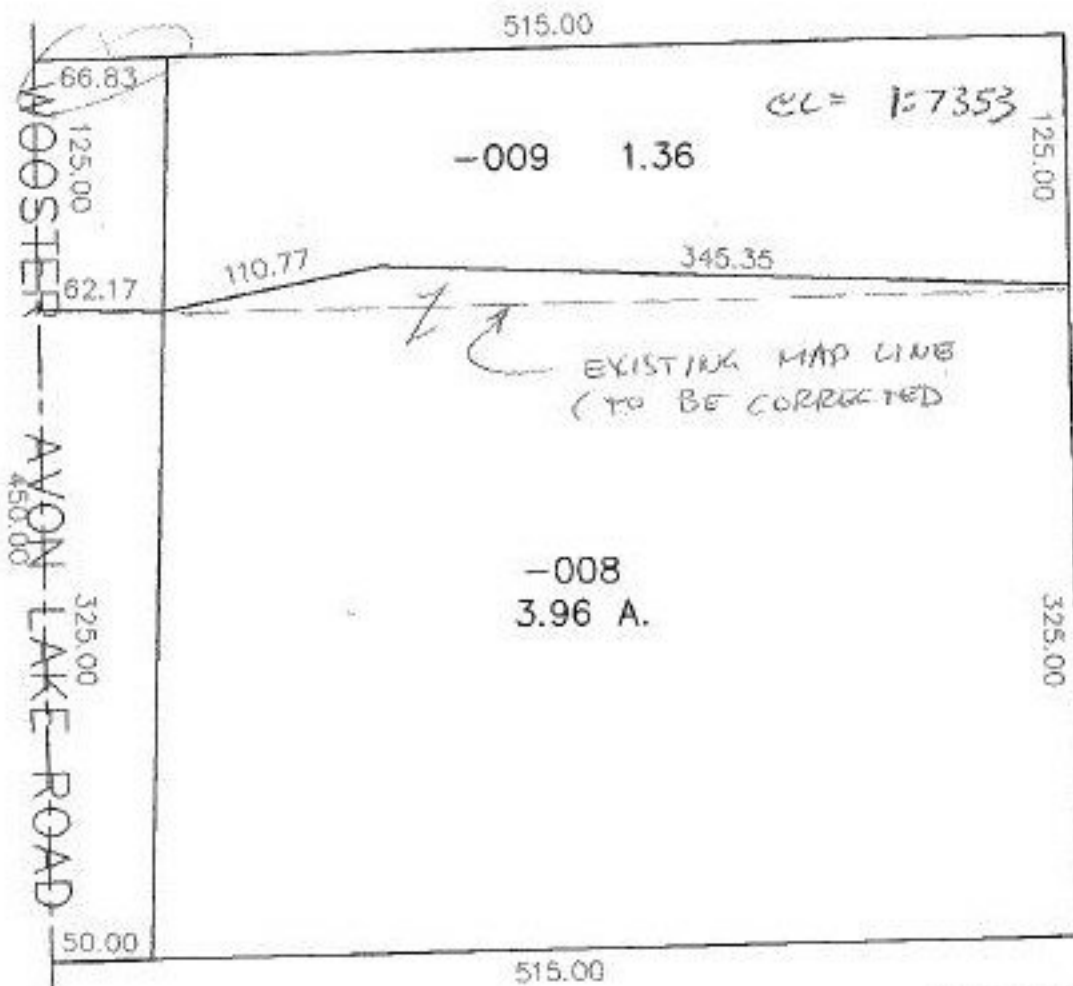

AS
2-22-00

PRIOR INSTRUMENT: DV 722/202
PRIOR INSTRUMENT: DV 1195/003
PRIOR INSTRUMENT: DV 1236/438

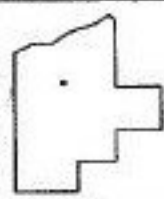

SPLITS/DEEDS PROCESSED
LORAIN COUNTY TAX MAP DEPARTMENT
226 MIDDLE AVE. ELYRIA, OHIO

SURVEYED BY: XXXXXXXXXXXX A.D. JEANCOLE
CLOSURE: XXXXXX 1:7553
MAP PAGE(S): 16-G
APPROVED BY: DRH DATE: 6/16/99
SCALE: 1" = 100' PRIOR INSTRUMENT: DV 1016/0694