


PARENT PARCEL: 03-00-024-000-021

CHILD PARCEL: 03-00-024-000-072 & -073

STARTING POINT: MON. BOX, CL OF HARRIS RD. & CL OF OSTER RD.

NO. 00143-D

# UNCOMBINATION

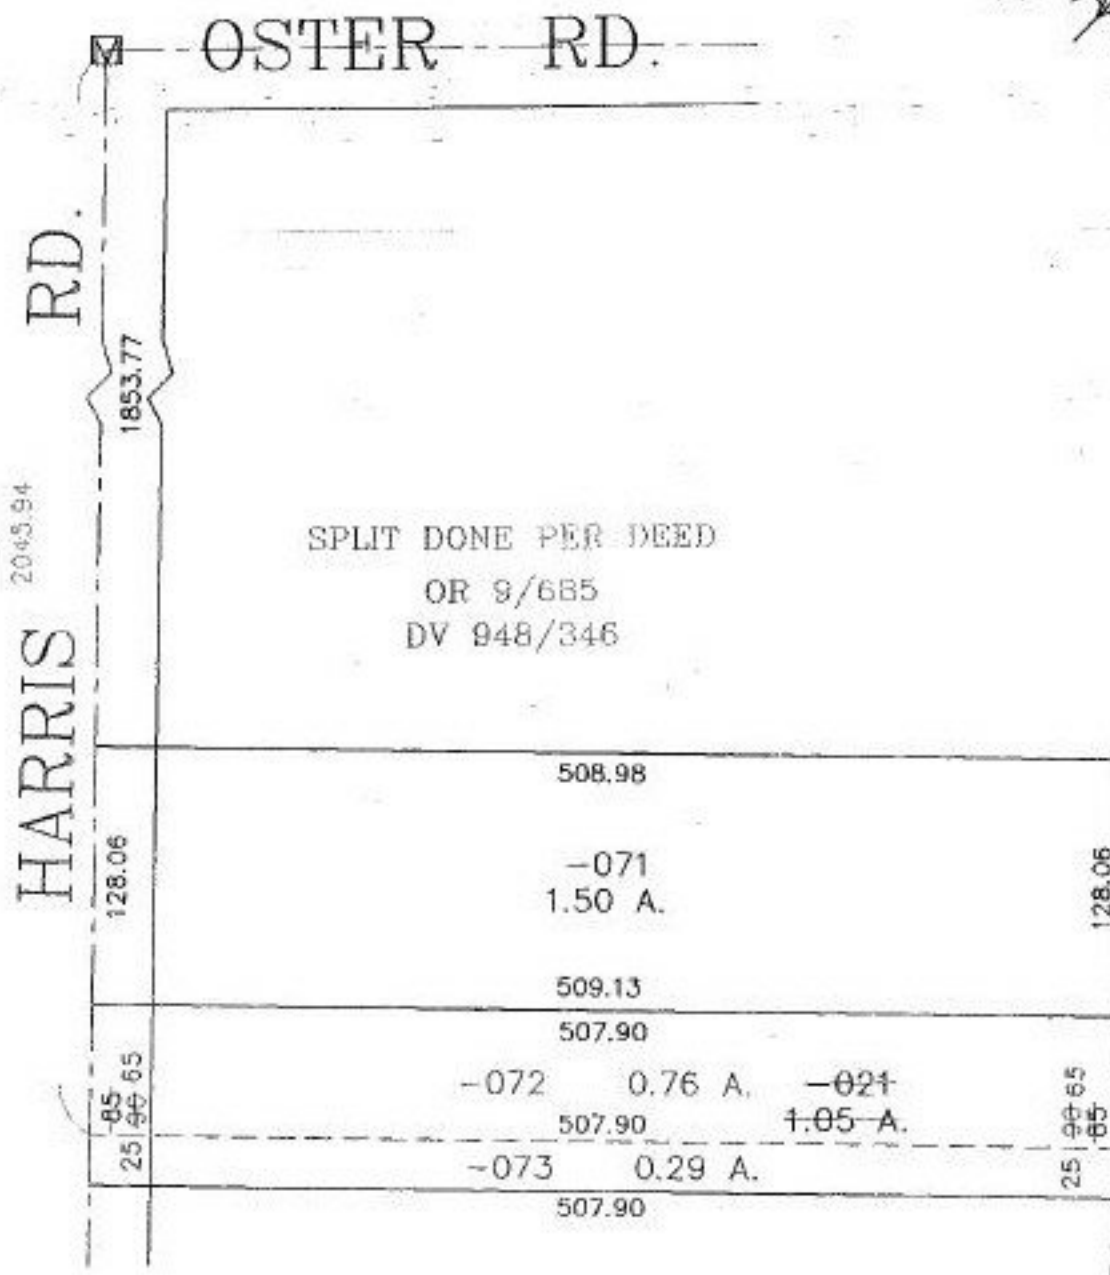

PRIOR INSTRUMENT: DV 948/346

PRIOR INSTRUMENT: OR 9/685

## SPLITS/DEEDS PROCESSED

LORAIN COUNTY TAX MAP DEPARTMENT  
226 MIDDLE AVE. ELYRIA, OHIO

SURVEYED BY: NONE

CLOSURE: CAN'T RUN

MAP PAGE(S): 03-00-024-A

APPROVED BY: I. SPILLMAN DATE: 07/30/99

SCALE: 1" = 100'